ASHBROOK

20110 ASHBROOK PL ASHBURN, VA 20147
SUITE 220

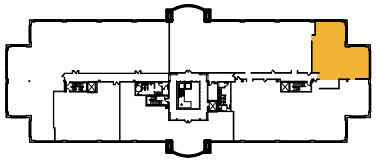

TOTAL SF AVAILABLE - 2,417 RSF(12%)

Click to access **3D** model

Key Plan

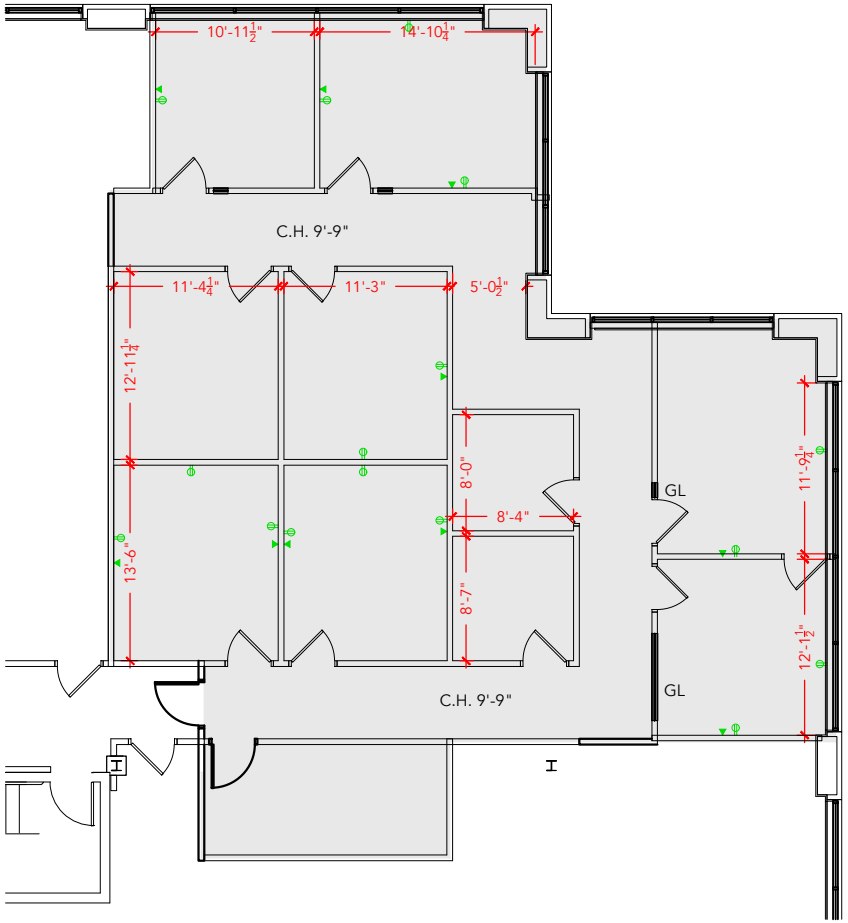

Floor Plan

PLAN NOT TO SCALE - THIS IS NOT A CONSTRUCTION DOCUMENT

DRAWING #: AB5-220 ASBUILT DATE:07.26.21