COLUMBIA CORPORATE PARK

8840 STANFORD BLVD COLUMBIA, MD 21045

SUITE 2100-2400&2700-2900

TOTAL SF AVAILABLE -18,549 RSF (12%)

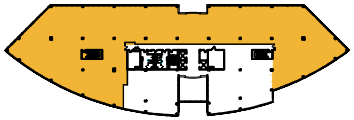

Key Plan

Click to access **3D** model

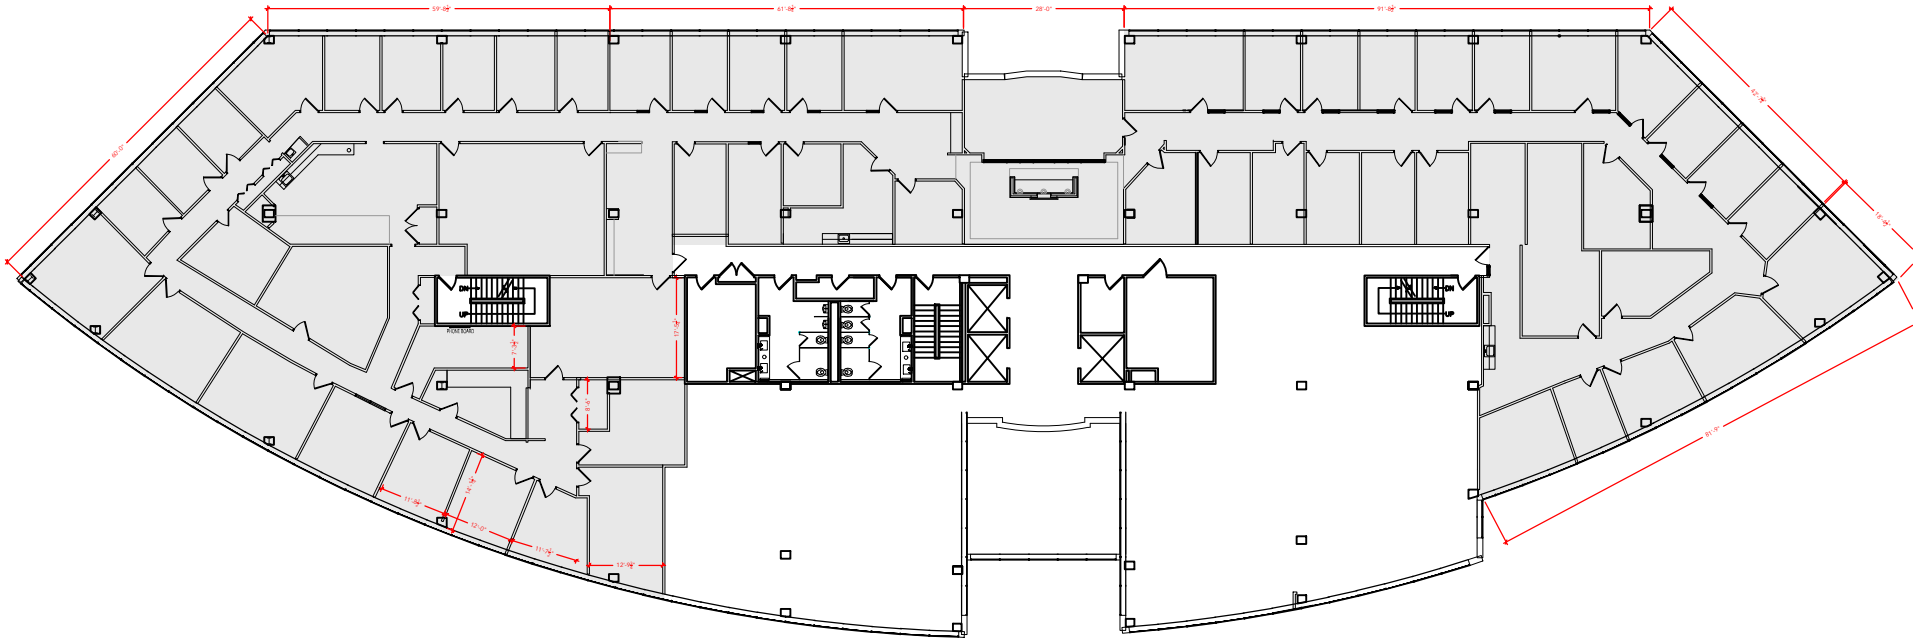

Floor Plan

PLAN NOT TO SCALE - THIS IS NOT A CONSTRUCTION DOCUMENT

DRAWING #: BH1-2100-2400 2700-2900 ASBUILT DATE: **NEEDS TO BE**