COLUMBIA CORPORATE PARK

8840 STANFORD BLVD COLUMBIA, MD 21045

SUITE 4400

TOTAL SF AVAILABLE - 6,169 RSF(16%)

Key Plan

Click to access **CADD file**

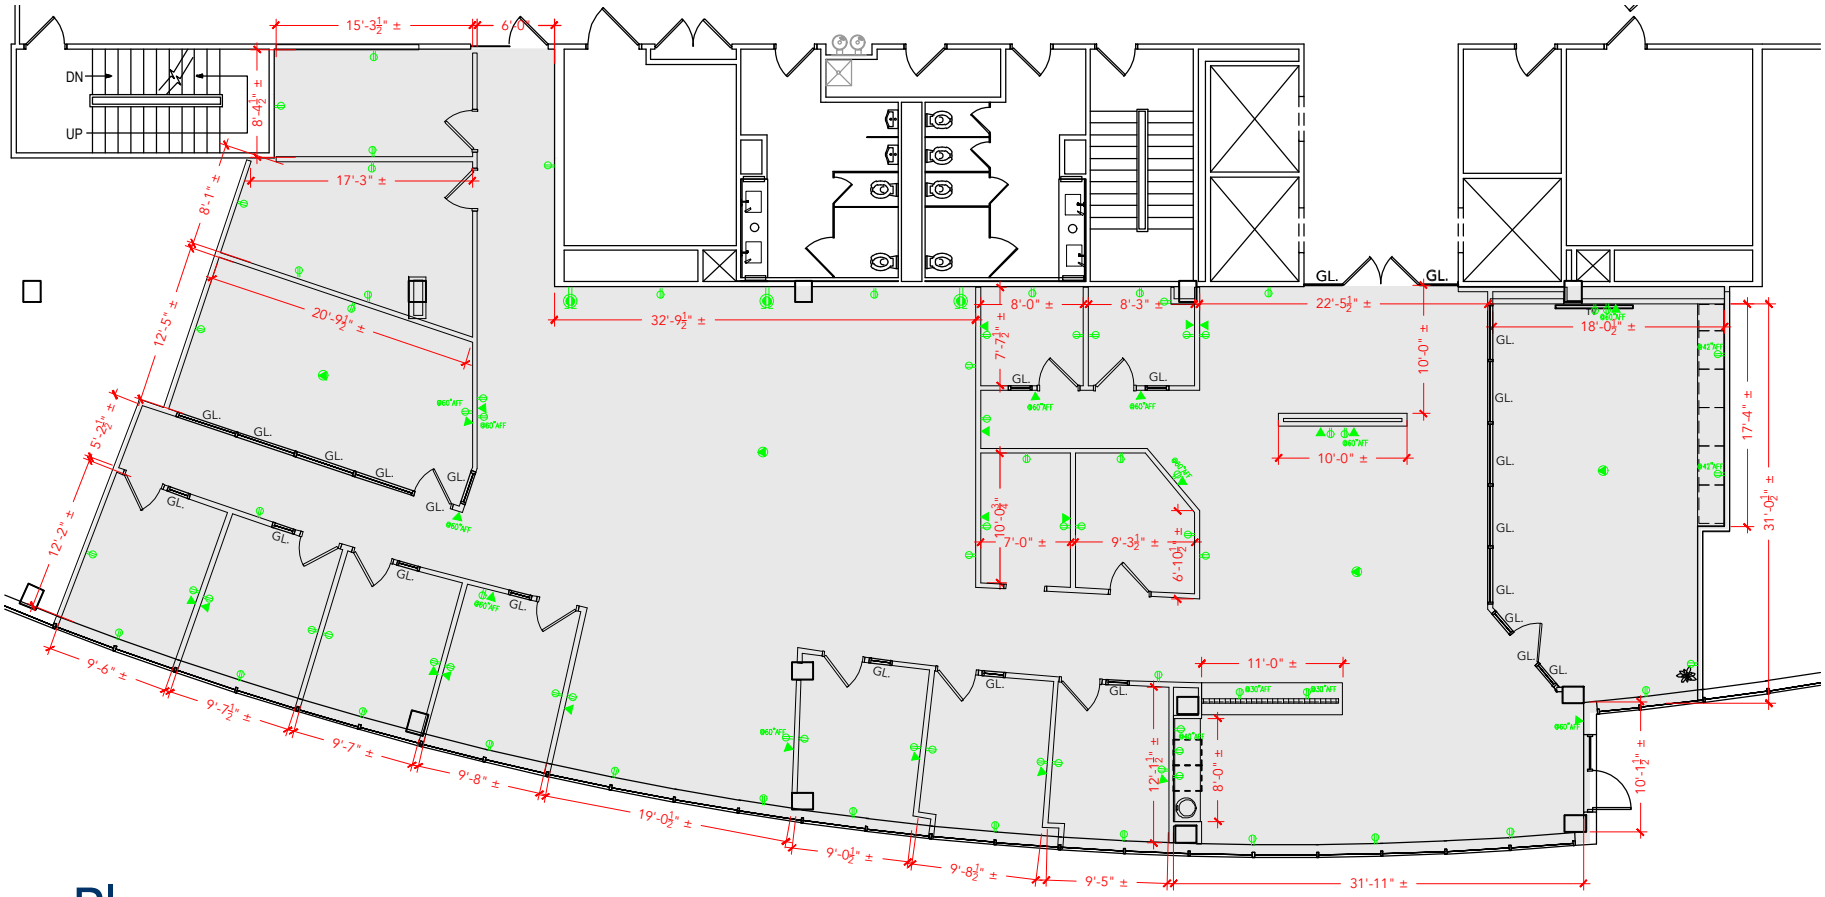

Floor Plan

PLAN NOT TO SCALE - THIS IS NOT A CONSTRUCTION DOCUMENT

DRAWING #: BH1-4400 ASBUILT DATE: 11.08.18