COLUMBIA CORPORATE PARK

8830 STANFORD BLVD. COLUMBIA, MD 21045

SUITE 312

TOTAL SF AVAILABLE -2,487 RSF (16%)

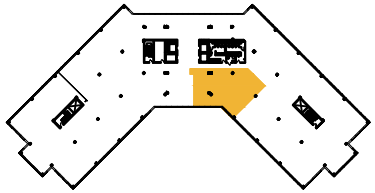

Key Plan

Click to access **3D** model

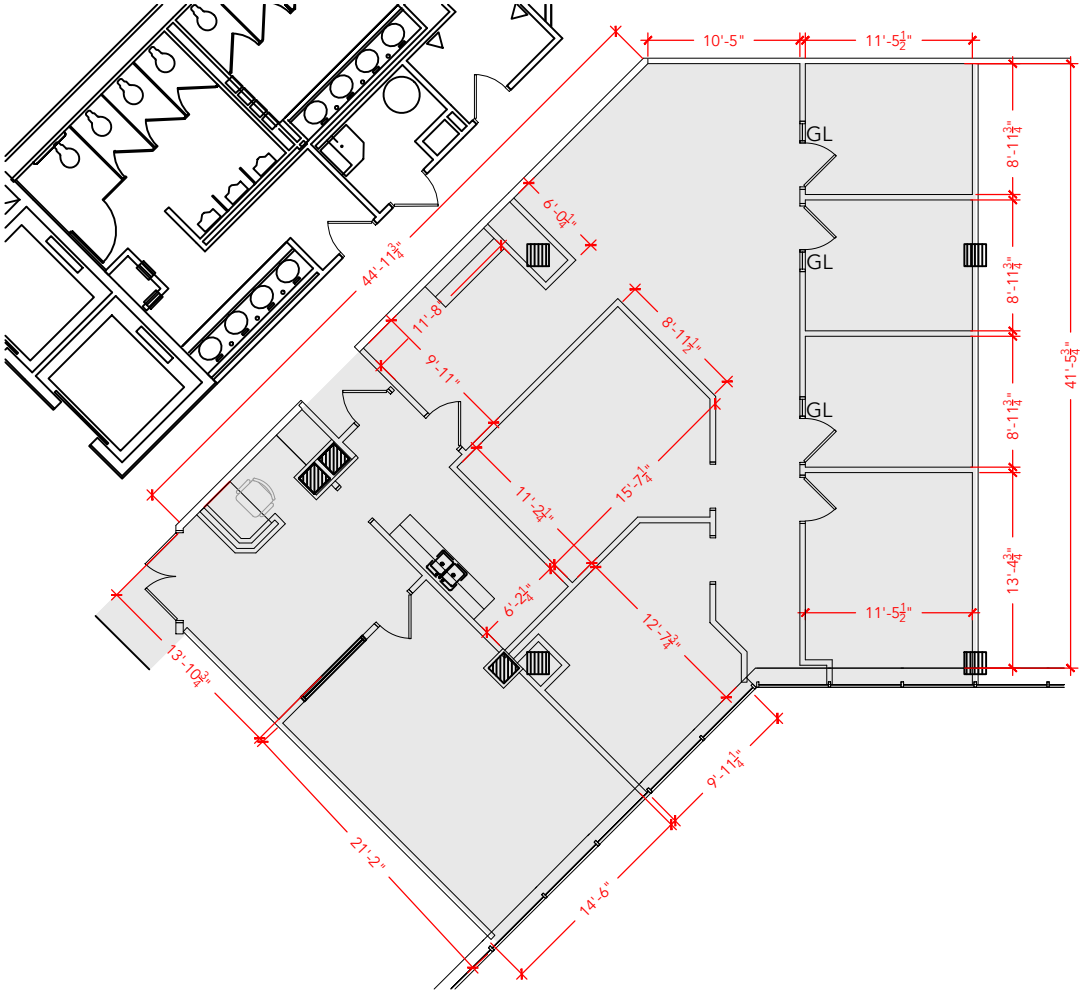

Floor Plan

PLAN NOT TO SCALE - THIS IS NOT A CONSTRUCTION DOCUMENT

DRAWING #: BH3-312 ASBUILT DATE: **NEEDS TO BE**