COLUMBIA CORPORATE PARK IV

8825 STANFORD BLVD. COLUMBIA, MD 21045

SUITE 100-120

TOTAL SF AVAILABLE - 9,897 RSF (16%)

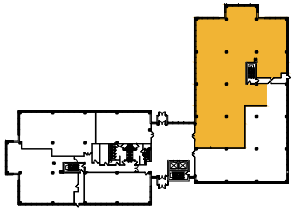

Key Plan

Click to access **3D** model

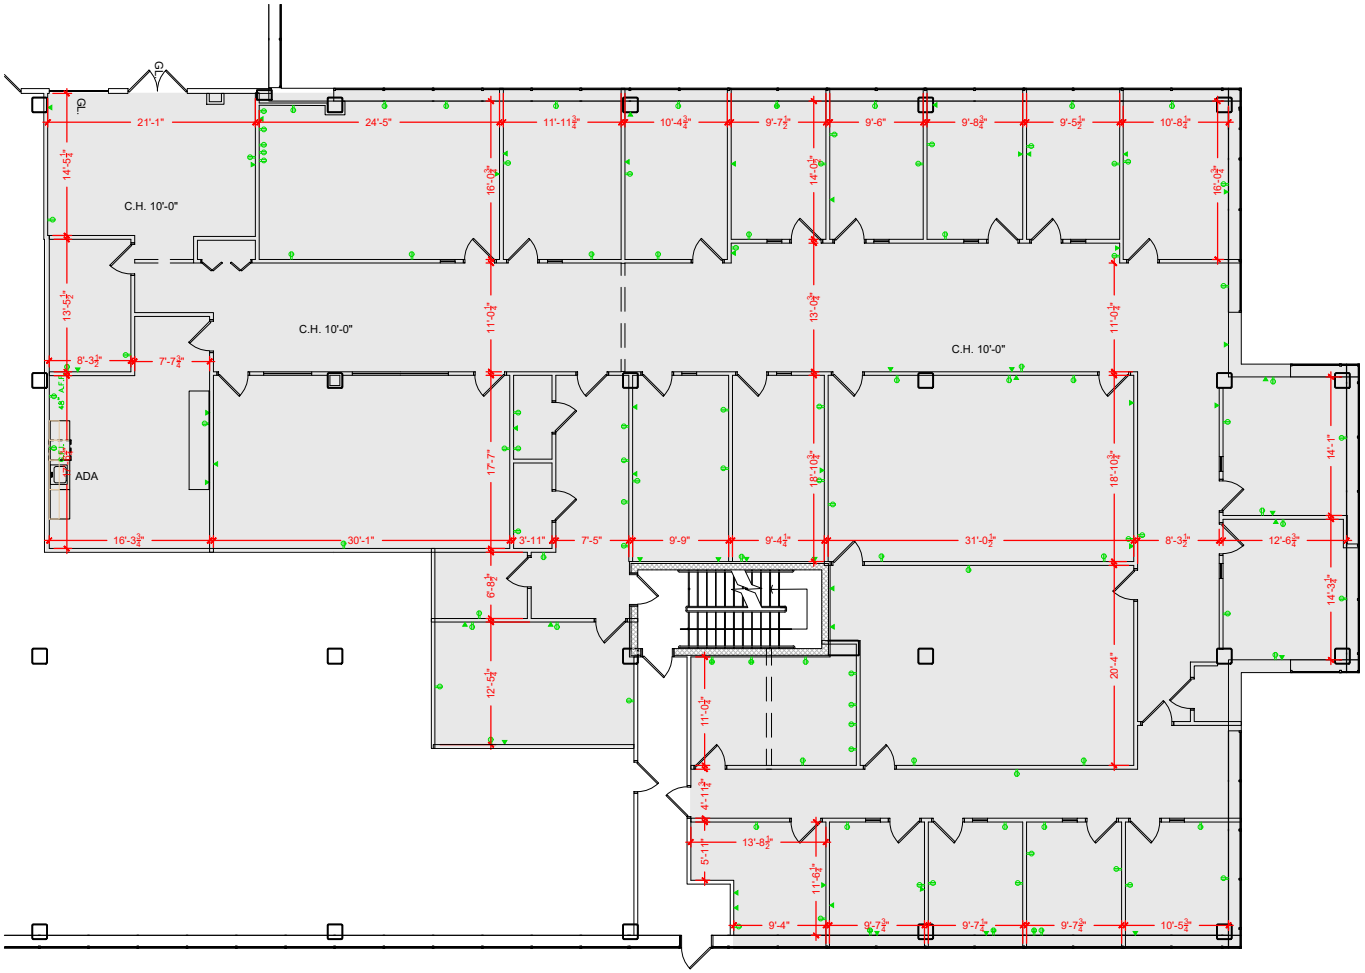

Floor Plan

PLAN NOT TO SCALE - THIS IS NOT A CONSTRUCTION DOCUMENT

DRAWING #: BH4-100-120 ASBUILT DATE:12.14.21