COLUMBIA CORPORATE PARK IV

8825 STANFORD BLVD. COLUMBIA, MD 21045

SUITE 150

TOTAL SF AVAILABLE -3,066 RSF (12%)

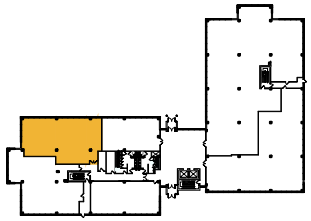

Key Plan

Click to access **3D** model

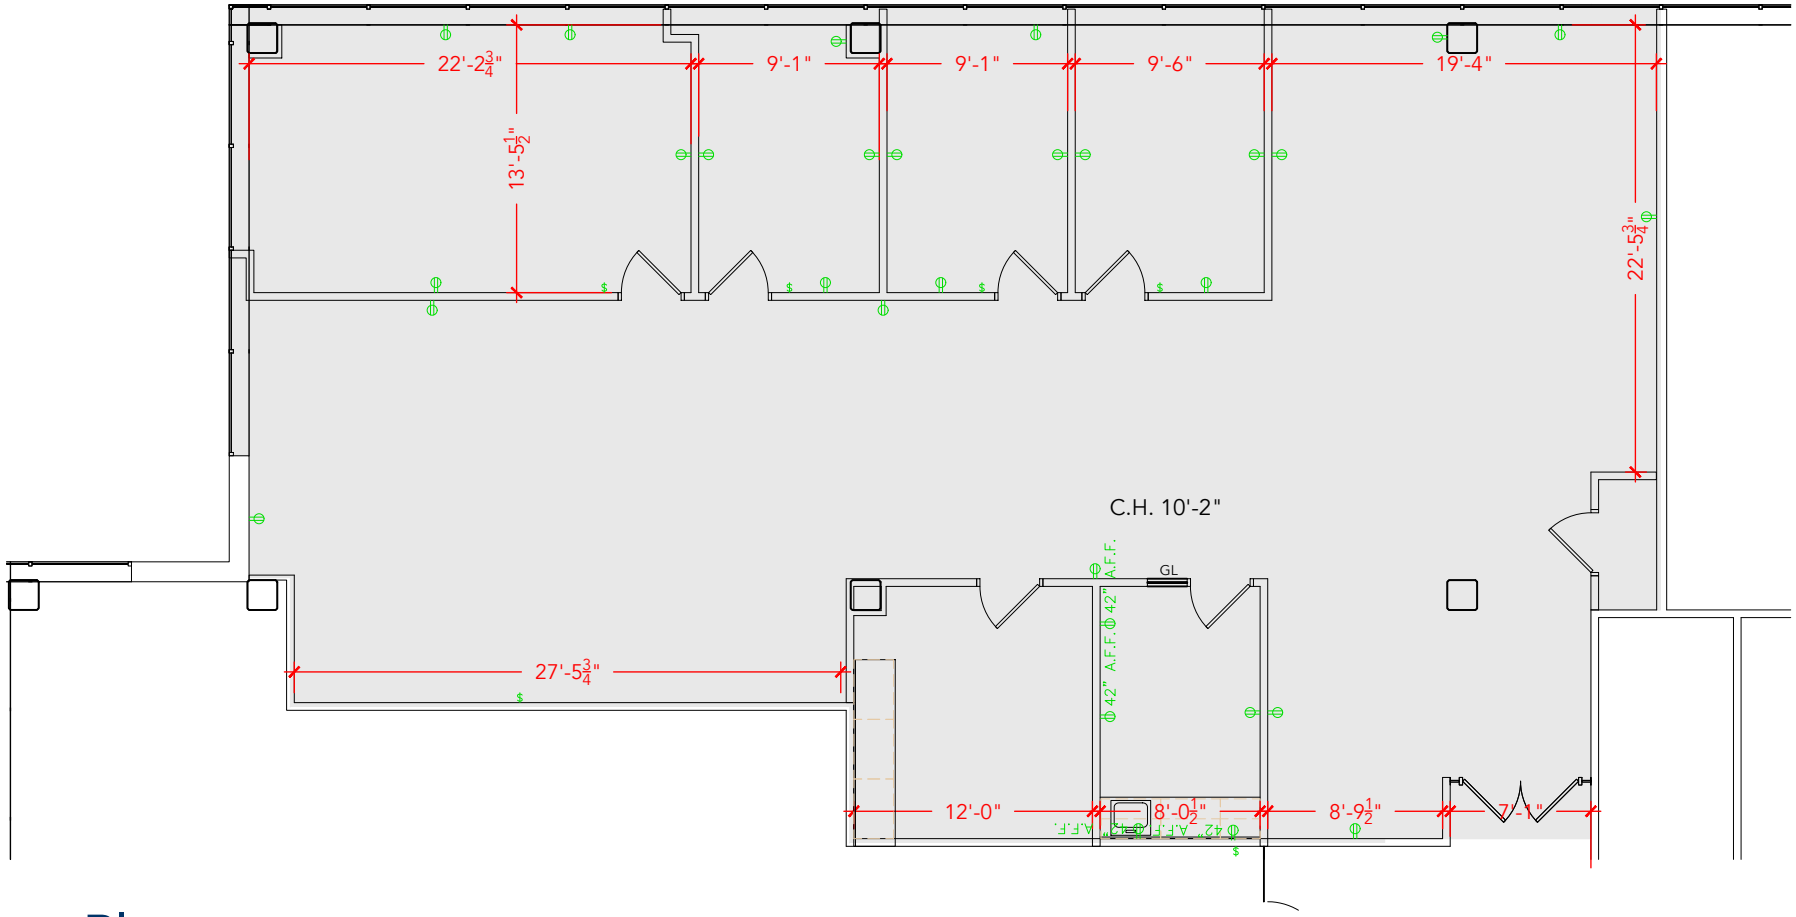

Floor Plan

PLAN NOT TO SCALE - THIS IS NOT A CONSTRUCTION DOCUMENT

DRAWING #: BH4-150 ASBUILT DATE:08.14.2020