COLUMBIA CORPORATE PARK IV

8825 STANFORD BLVD. COLUMBIA, MD 21045

SUITE 300-330

TOTAL SF AVAILABLE -14,860 RSF(16%)

Key Plan

Click to access **3D** model

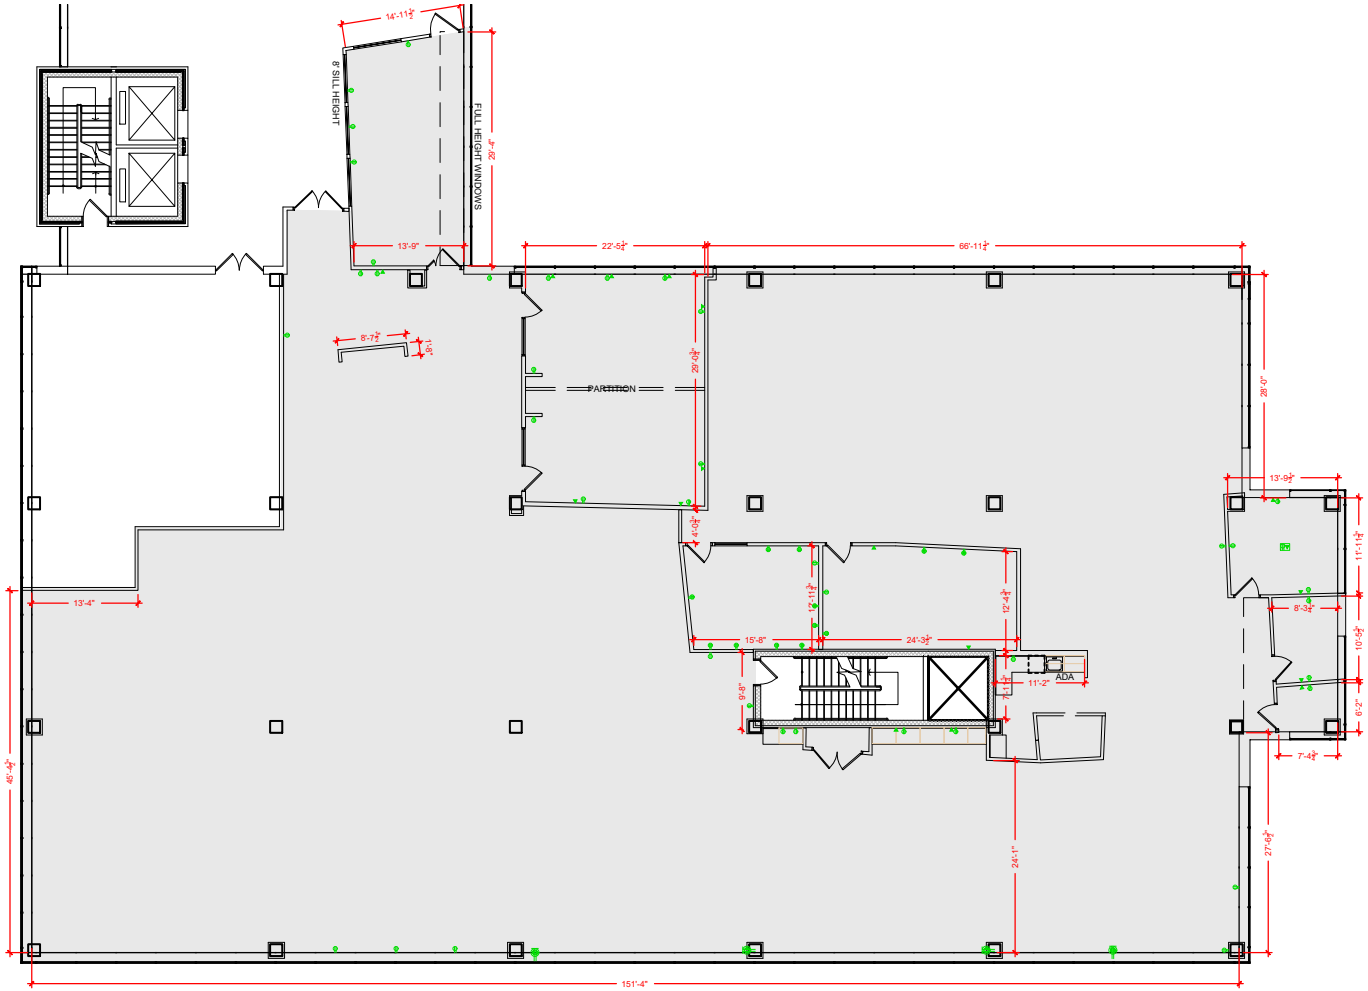

Floor Plan

PLAN NOT TO SCALE - THIS IS NOT A CONSTRUCTION DOCUMENT

DRAWING #: BH4-300-330 ASBUILT DATE:08.02.21