COLUMBIA CORPORATE PARK

8890 MCGAW RD. COLUMBIA, MD 21045

SUITE 150-180

TOTAL SF AVAILABLE - 9,068 RSF(12%)

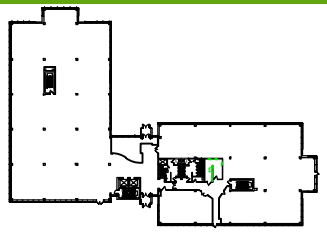

Key Plan

Click to access **3D** model

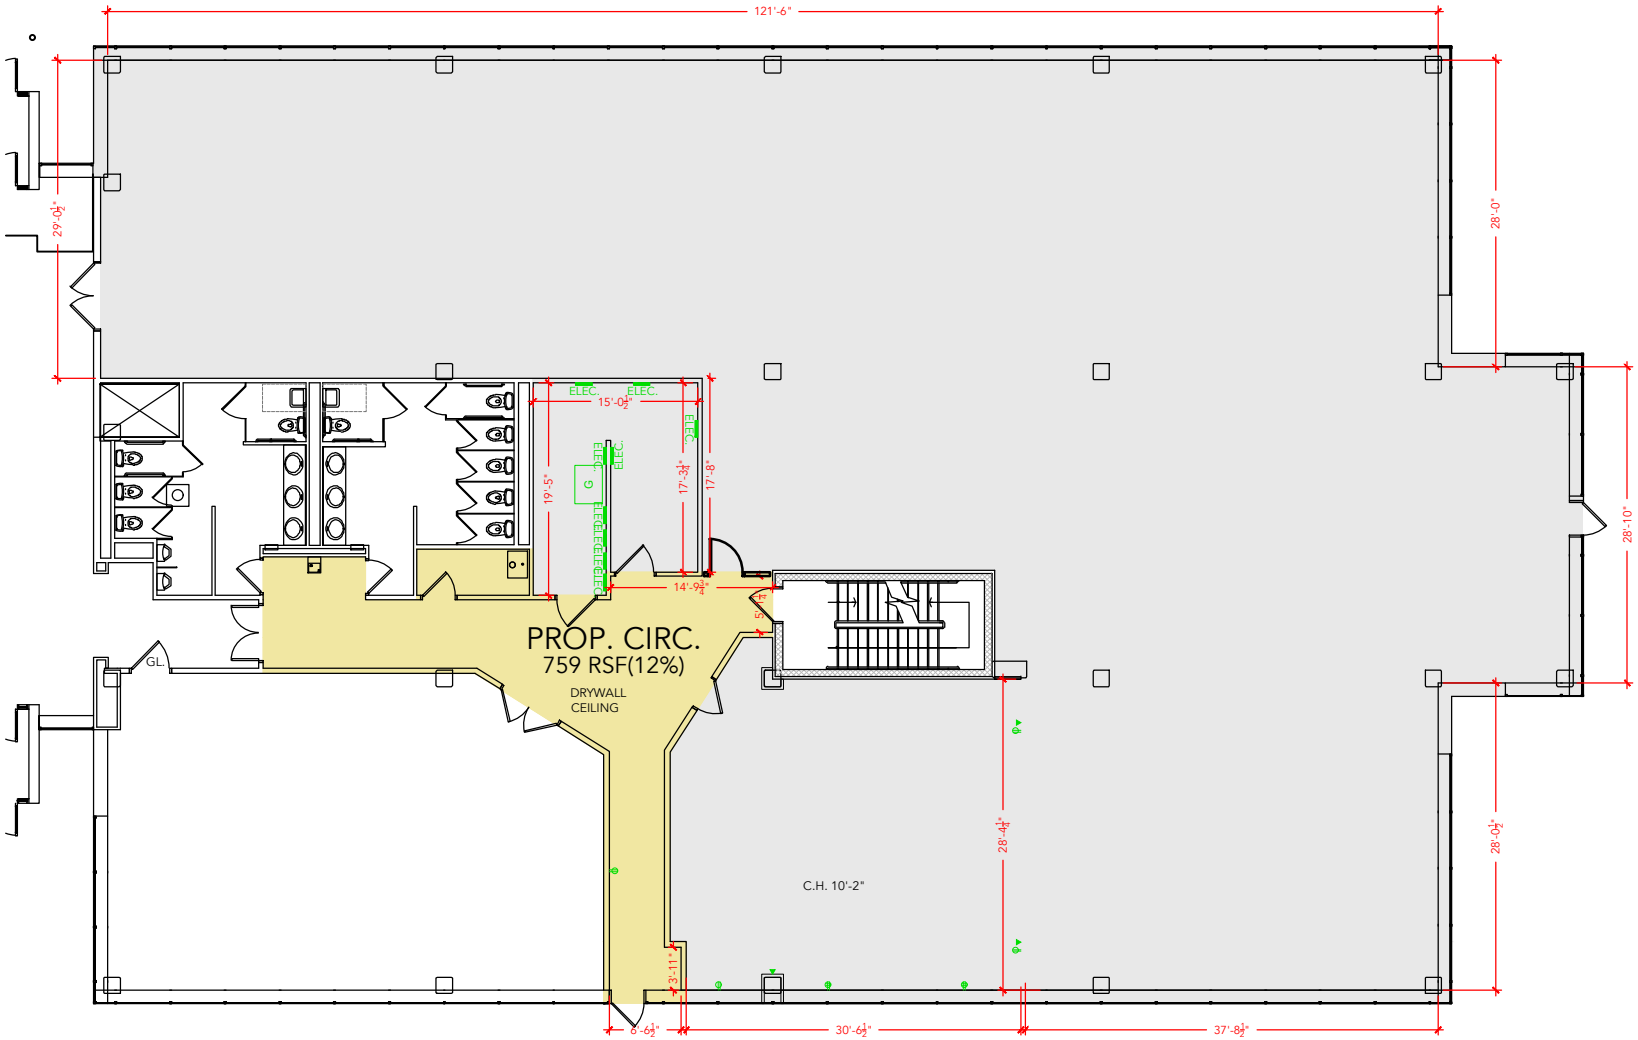

Floor Plan

PLAN NOT TO SCALE - THIS IS NOT A CONSTRUCTION DOCUMENT

DRAWING #: BH5-150-180 ASBUILT DATE:10.01.2020