COLUMBIA CORPORATE PARK

8890 MCGAW RD. COLUMBIA, MD 21045

SUITE 300

TOTAL SF AVAILABLE - 15,091 RSF(12%)

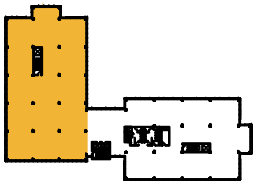

Key Plan

Click to access **3D** model

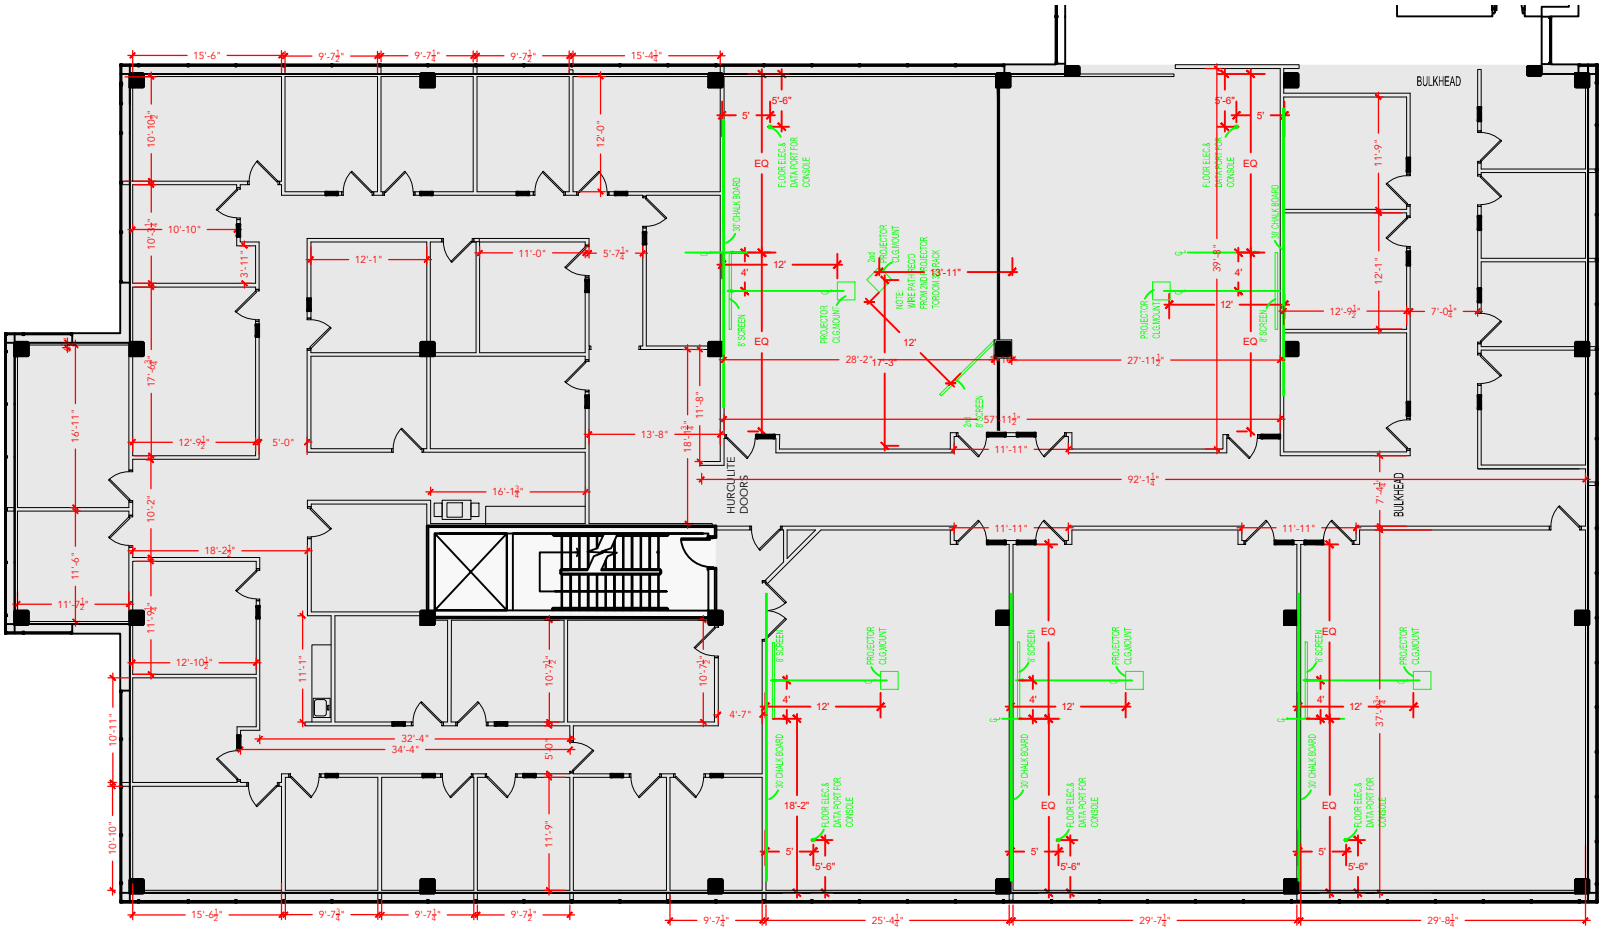

Floor Plan

PLAN NOT TO SCALE - THIS IS NOT A CONSTRUCTION DOCUMENT

DRAWING #: BH5-300 ASBUILT DATE: **NEEDS TO BE**