BEAUMEADE CORPORATE PARK

44611 GUILFORD DRIVE, ASHBURN, VA 20147

SUITE 110

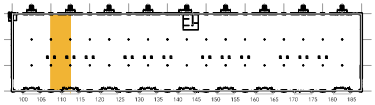

Key Plan

TOTAL SF AVAILABLE - 3,636 RSF

OFFICE - 1,826 SF

WAREHOUSE SF - 1,810 SF

* INCLUDES % OF METER ROOM

Click to access **3D** model

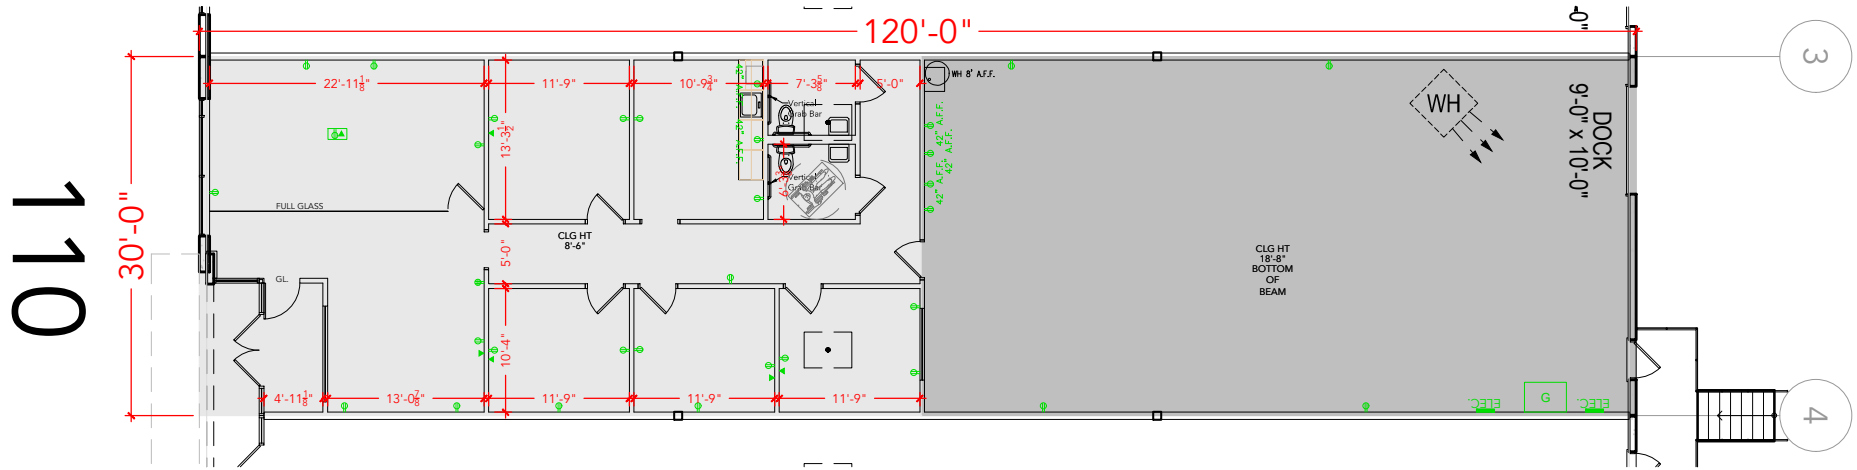

Floor Plan

PLAN NOT TO SCALE - THIS IS NOT A CONSTRUCTION DOCUMENT

DRAWING #: BM1-110 ASBUILT DATE: **03.12.19**