merritt PROPERTIES

DESOTO ROAD

1408-1414 DESOTO ROAD BALTIMORE, MD 21230

SUITE 1408-1414

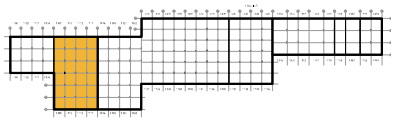

TOTAL SF AVAILABLE - 24,000 SF

OFFICE - 5,125 SF

WAREHOUSE - 18,875 SF

Click to access 3D model

Key Plan

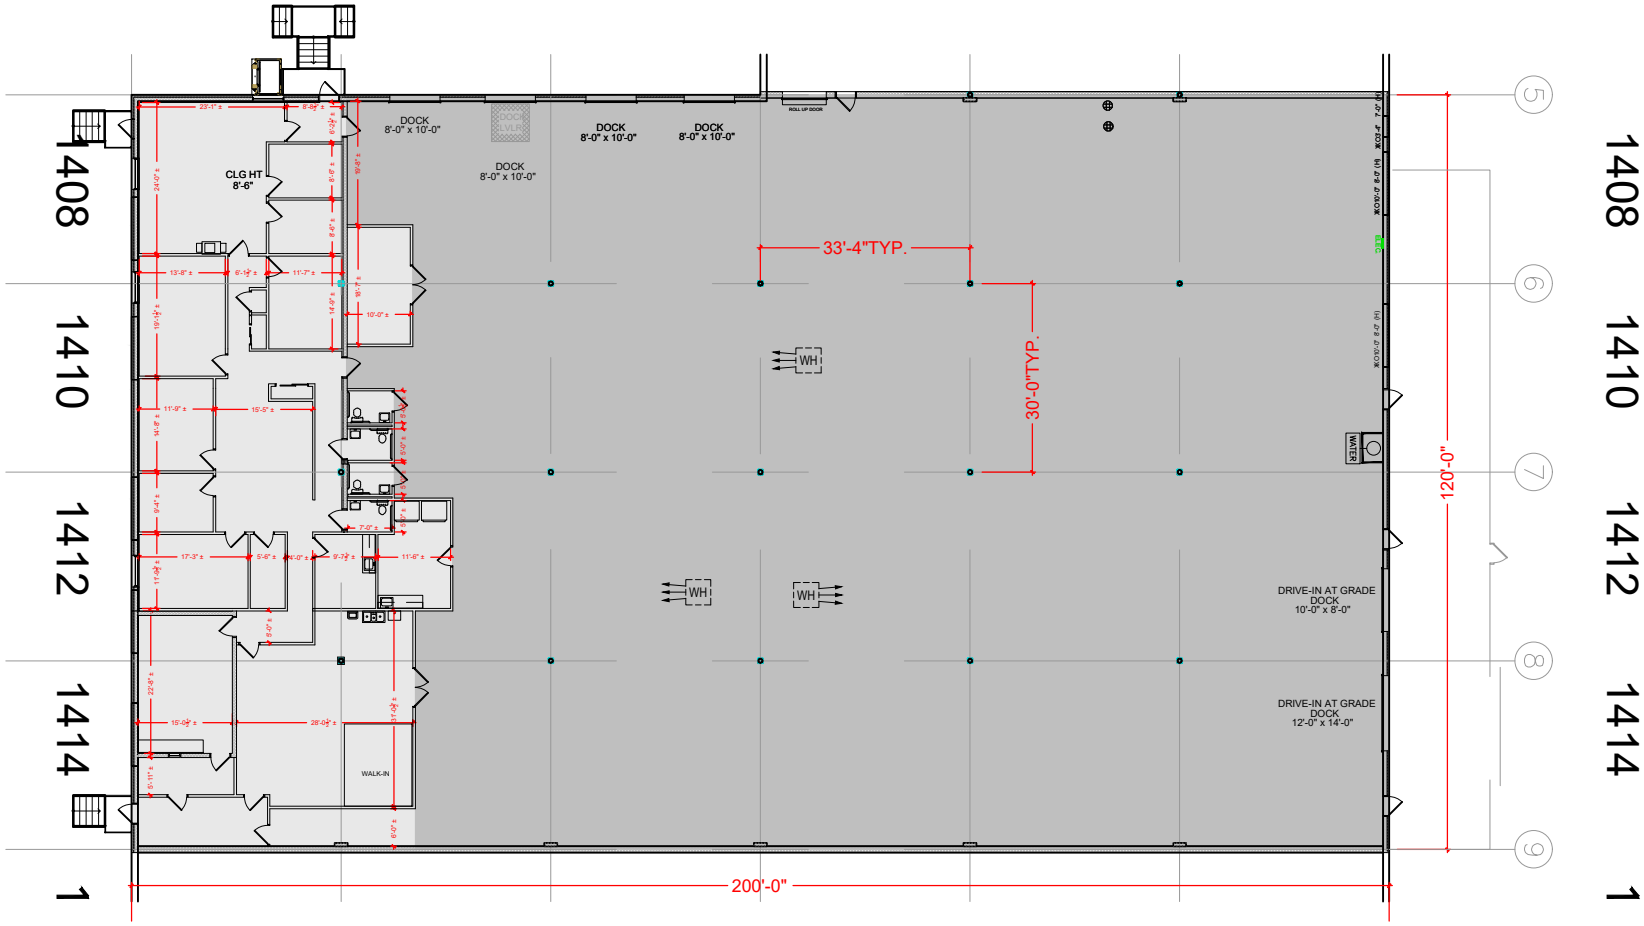

Floor Plan

PLAN NOT TO SCALE - THIS IS NOT A CONSTRUCTION DOCUMENT

DRAWING #: DJ1-1408-1414 ASBUILT DATE: NEEDS TO BE