BELTWAY BUSINESS PARK

1730 TWIN SPRINGS ROAD BALTIMORE, MD 21227


SUITE 219-222

TOTAL SF AVAILABLE - 12,000 SF


OFFICE - 5,306 SF

WAREHOUSE SF - 6,694 SF

Click to access **CADD file**

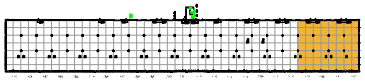

Key Plan

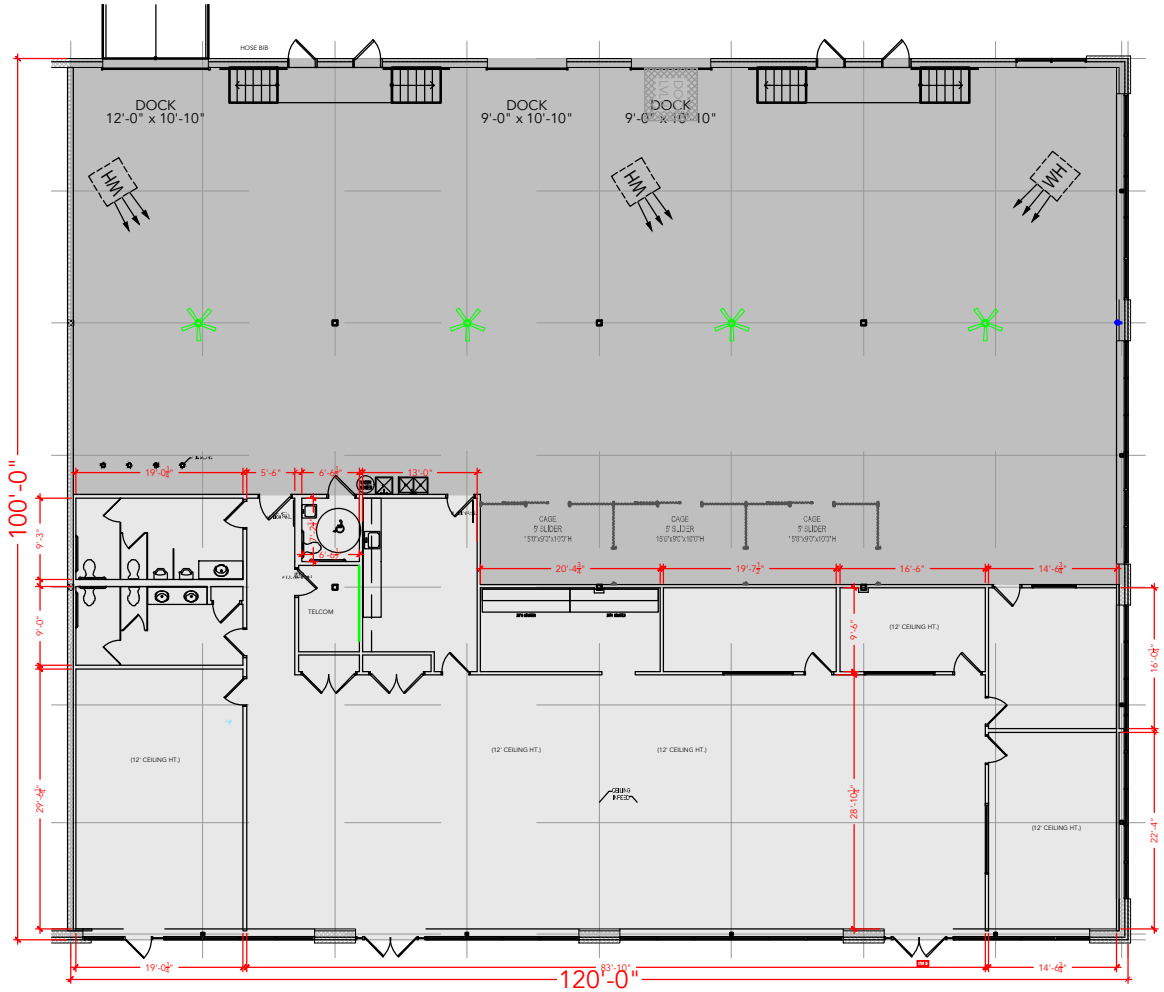

Floor Plan

PLAN NOT TO SCALE - THIS IS NOT A CONSTRUCTION DOCUMENT

DRAWING #: EC2-3-219-222 ASBUILT DATE: **02.02.17**