THE EXCHANGE

1122 KENILWORTH DR. TOWSON, MD 21204

SUITE 213-214

TOTAL SF AVAILABLE -2,897 RSF (12.6%

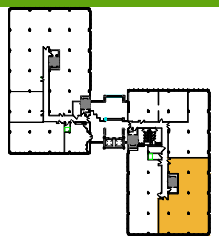

Key Plan

Click to access **CADD file**

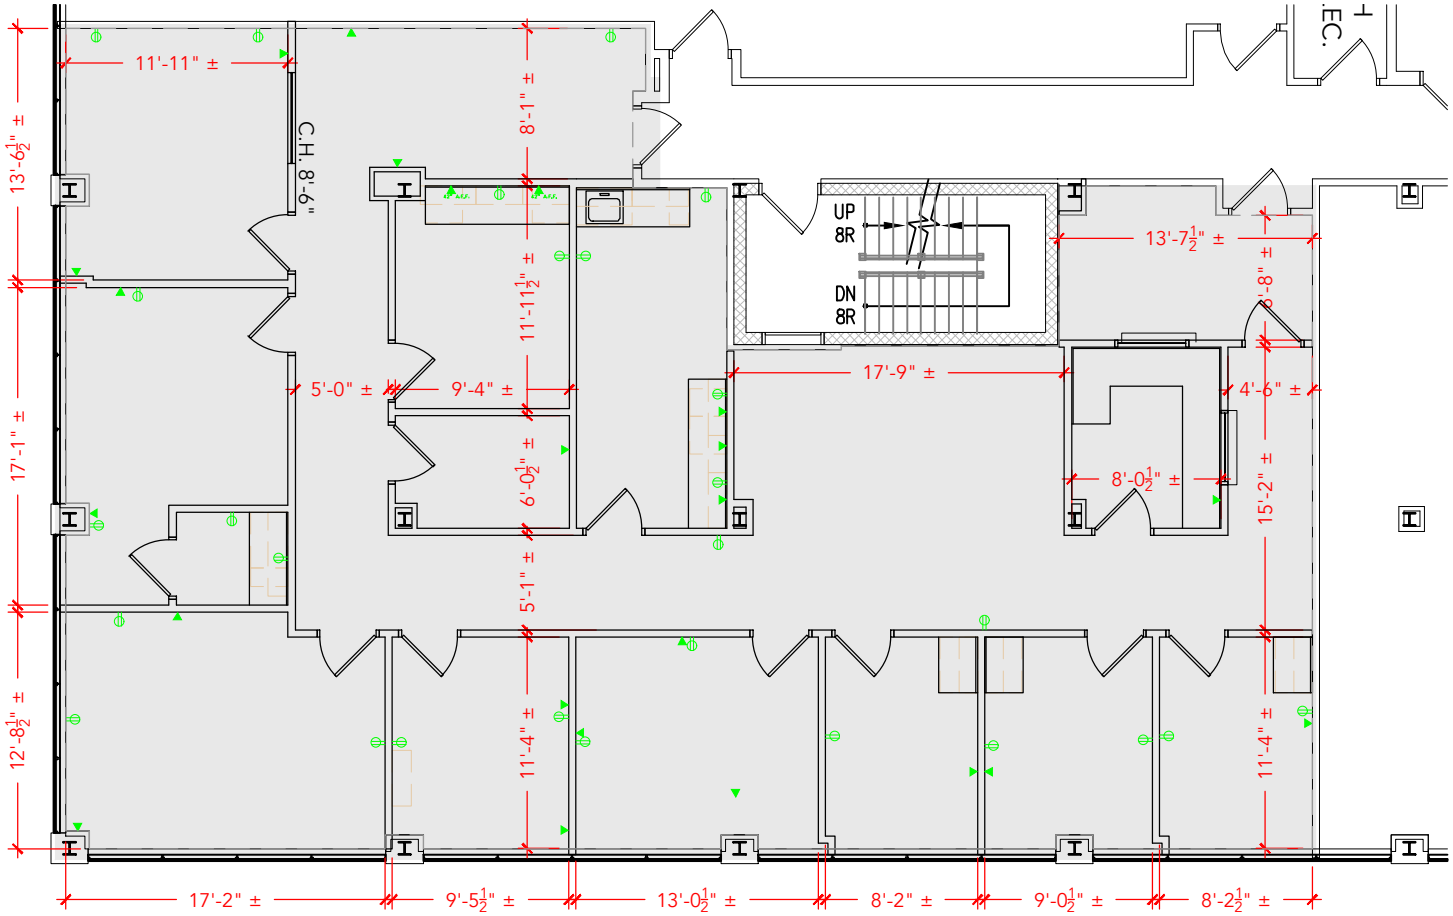

Floor Plan

PLAN NOT TO SCALE - THIS IS NOT A CONSTRUCTION DOCUMENT

DRAWING #: EX1-213-214 ASBUILT DATE: **10.02.25**