THE EXCHANGE

1122 KENILWORTH DR. TOWSON, MD 21204

SUITE 217

TOTAL SF AVAILABLE -2,321 RSF(12.6%)

Click to access **CADD file**

Key Plan

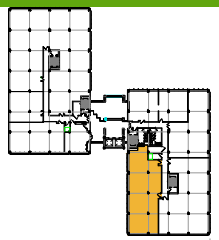

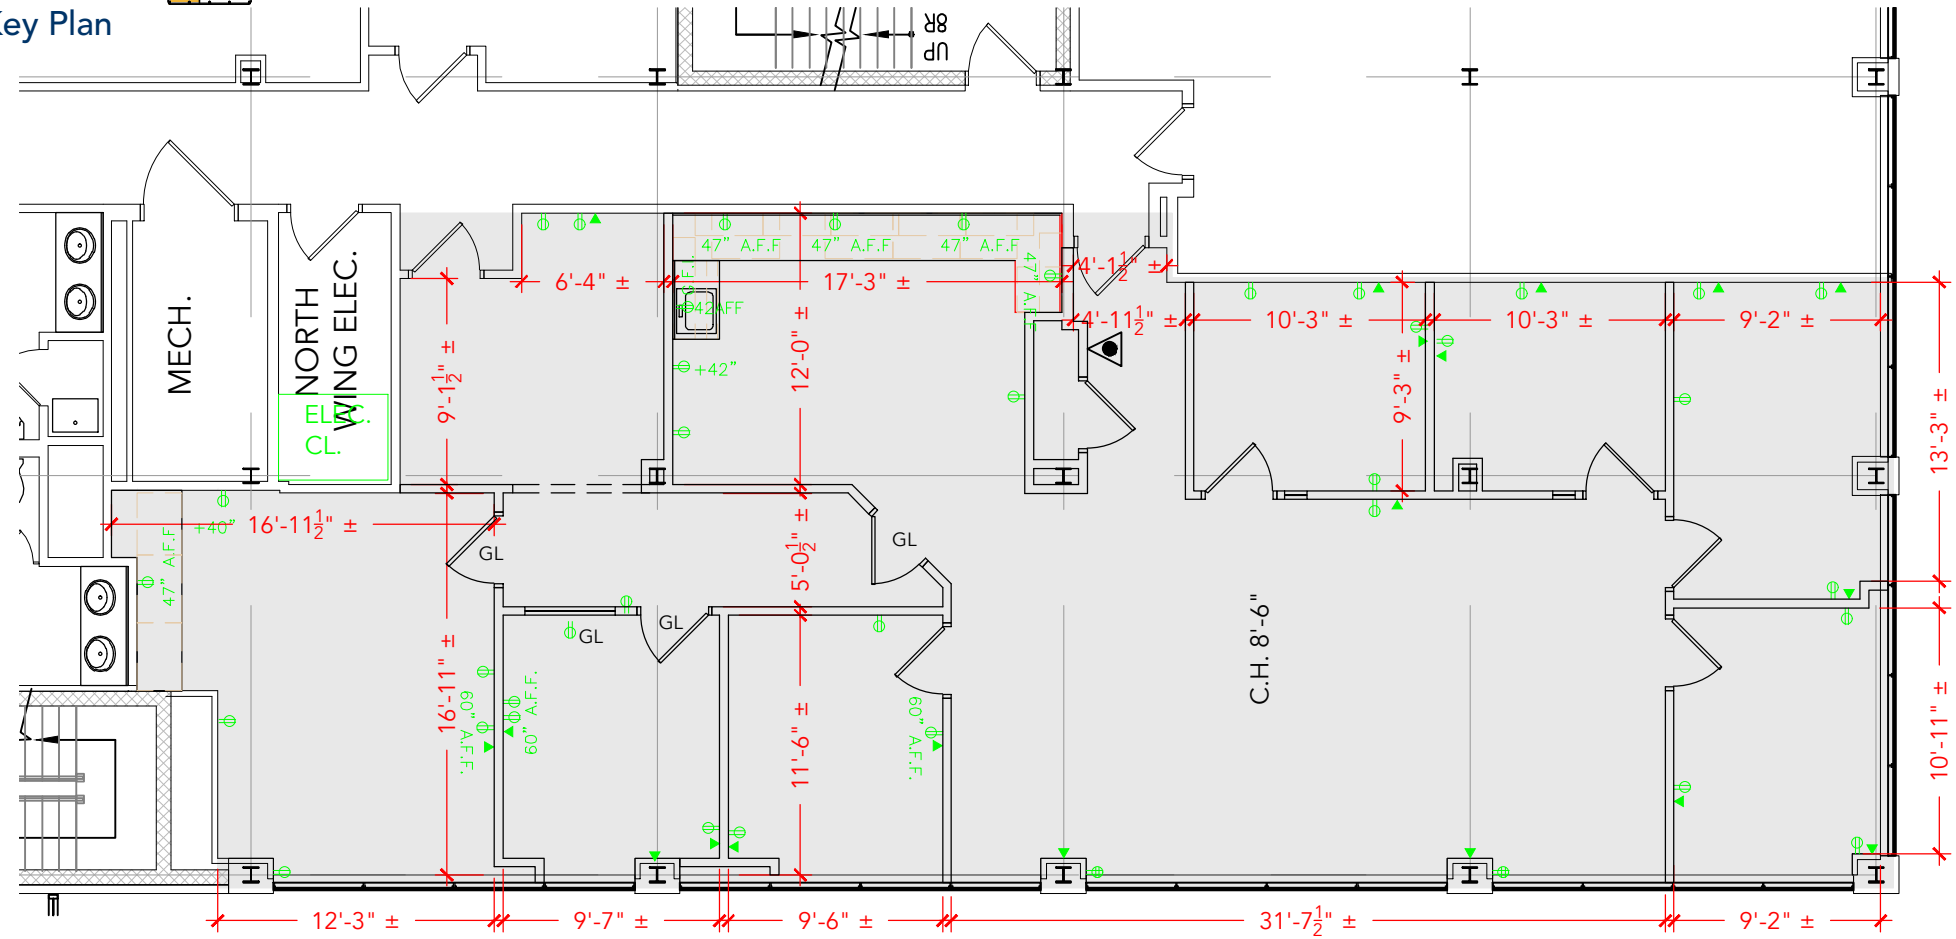

Floor Plan

PLAN NOT TO SCALE - THIS IS NOT A CONSTRUCTION DOCUMENT

DRAWING #: EX1-217 ASBUILT DATE: 10.02.25