729 EAST PRATT

729 EAST PRATT ST. BALTIMORE, MD 21202
SUITE 850

TOTAL SF AVAILABLE -2,049 RSF(12%)

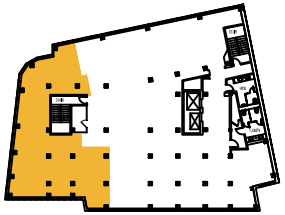

Key Plan

Click to access **3D** model

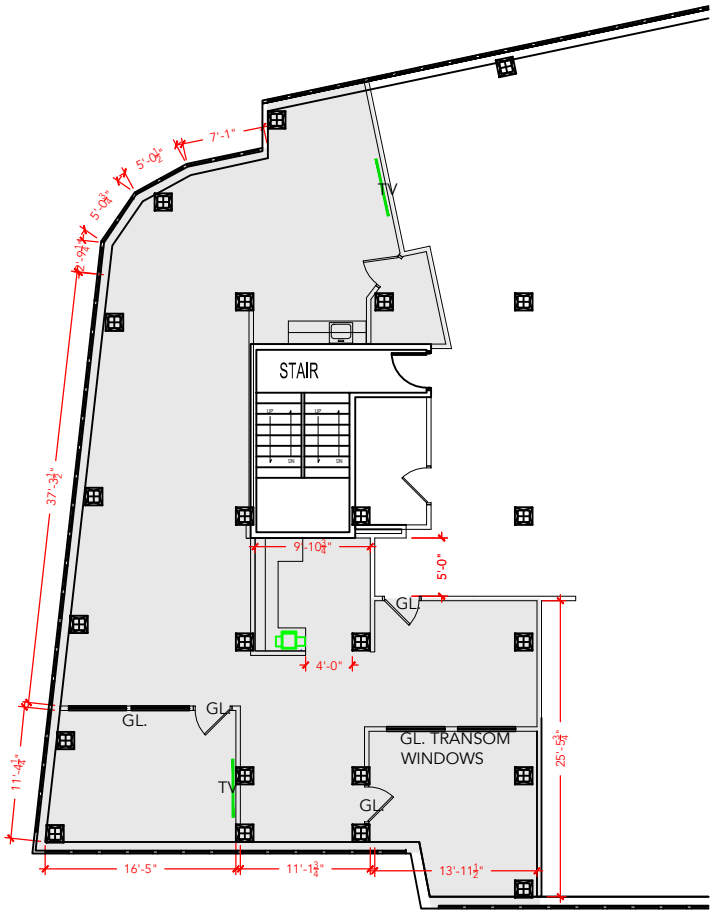

Floor Plan

PLAN NOT TO SCALE - THIS IS NOT A CONSTRUCTION DOCUMENT

DRAWING #: HA1-729-850 ASBUILT DATE: NEEDS TO BE