# CCP 100

6011 UNIVERSITY BLVD ELLICOTT CITY, MD 21043
SUITE 200

## TOTAL SF AVAILABLE - 3,590 RSF (12%)

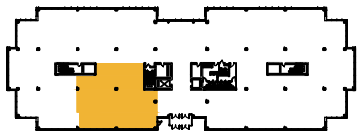

Key Plan

Click to access **3D** model
Matterport Scan

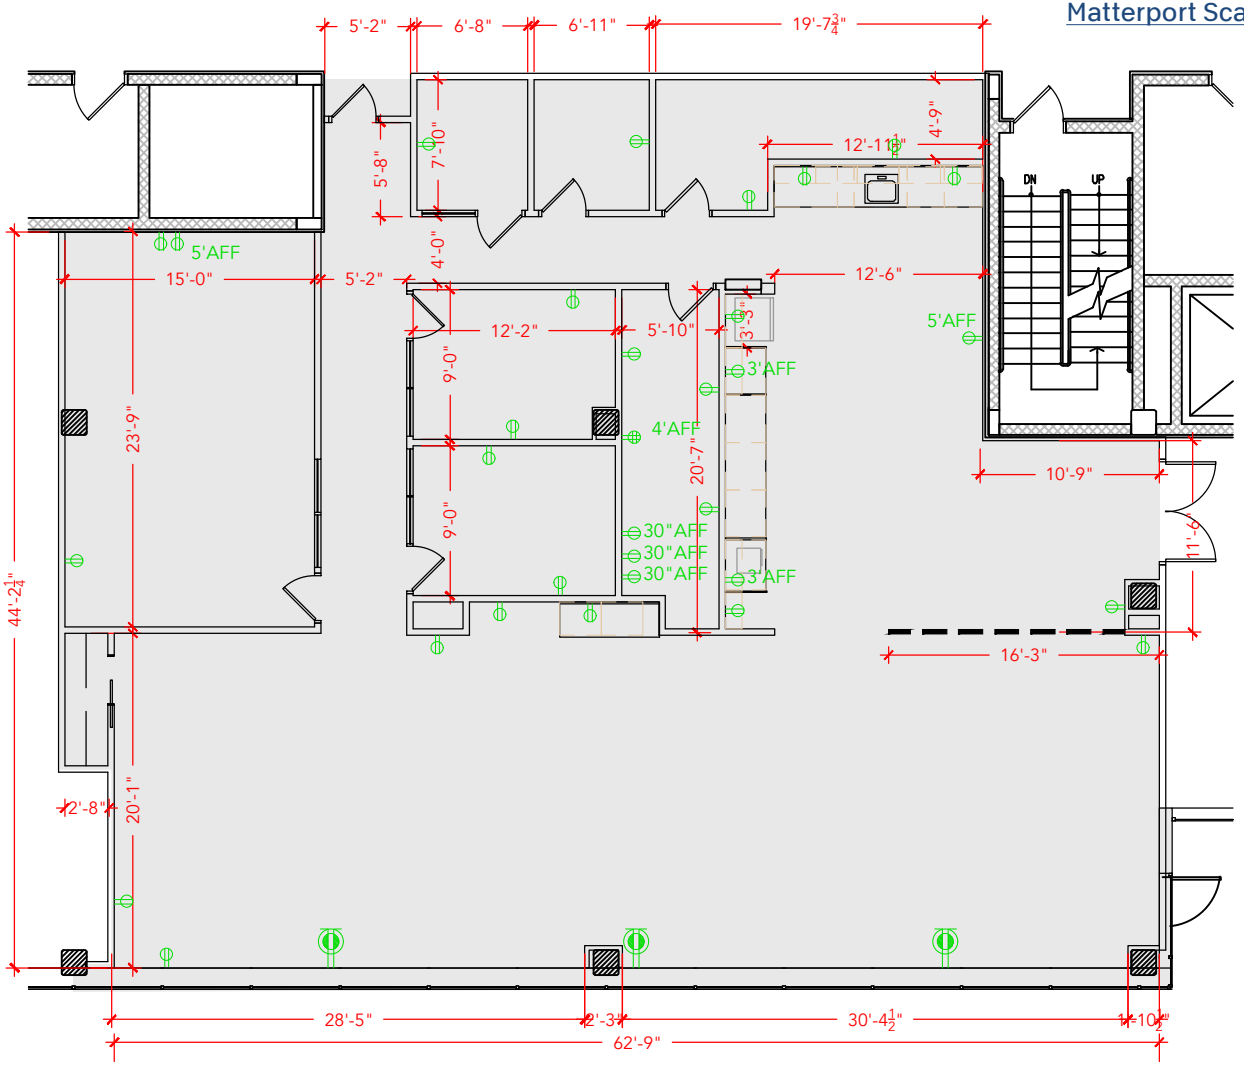


# Floor Plan

PLAN NOT TO SCALE - THIS IS NOT A CONSTRUCTION DOCUMENT

DRAWING #: HF2-200 ASBUILT DATE: FIELD VERIFI