CCP 100

6021 UNIVERSITY BLVD. ELLICOTT CITY, MD 21043

SUITE 215

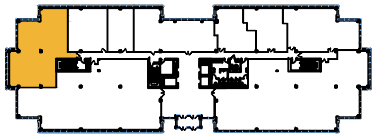

TOTAL SF AVAILABLE - 2,619 RSF (16%)

Click to access **CADD file**

Key Plan

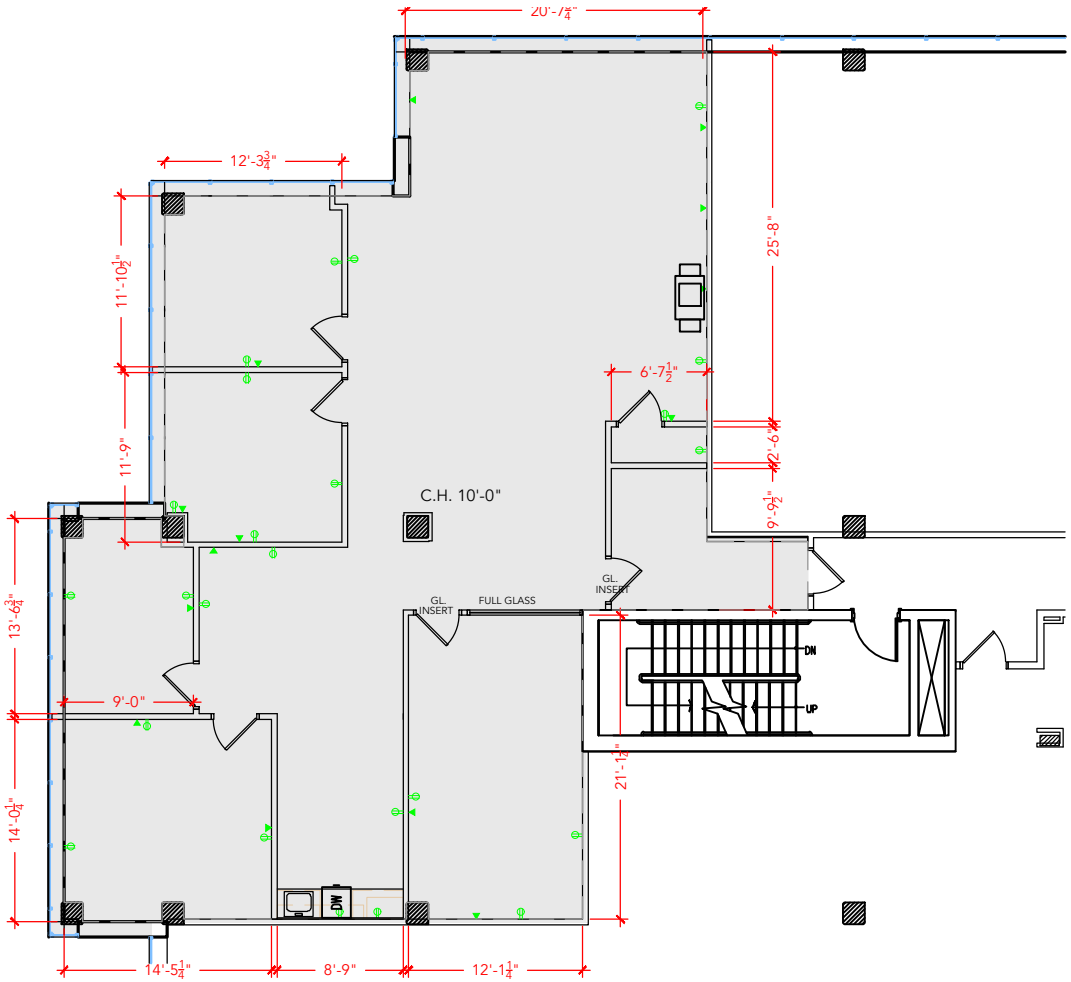

Floor Plan

PLAN NOT TO SCALE - THIS IS NOT A CONSTRUCTION DOCUMENT

DRAWING #: HF3-215 ASBUILT DATE: 11.19.20