merritt PROPERTIES

CCP 100

6021 UNIVERSITY BLVD. ELLICOTT CITY, MD 21043
SUITE 290

TOTAL SF AVAILABLE - 6,042 RSF(12%)

Click to access **3D** model

Key Plan

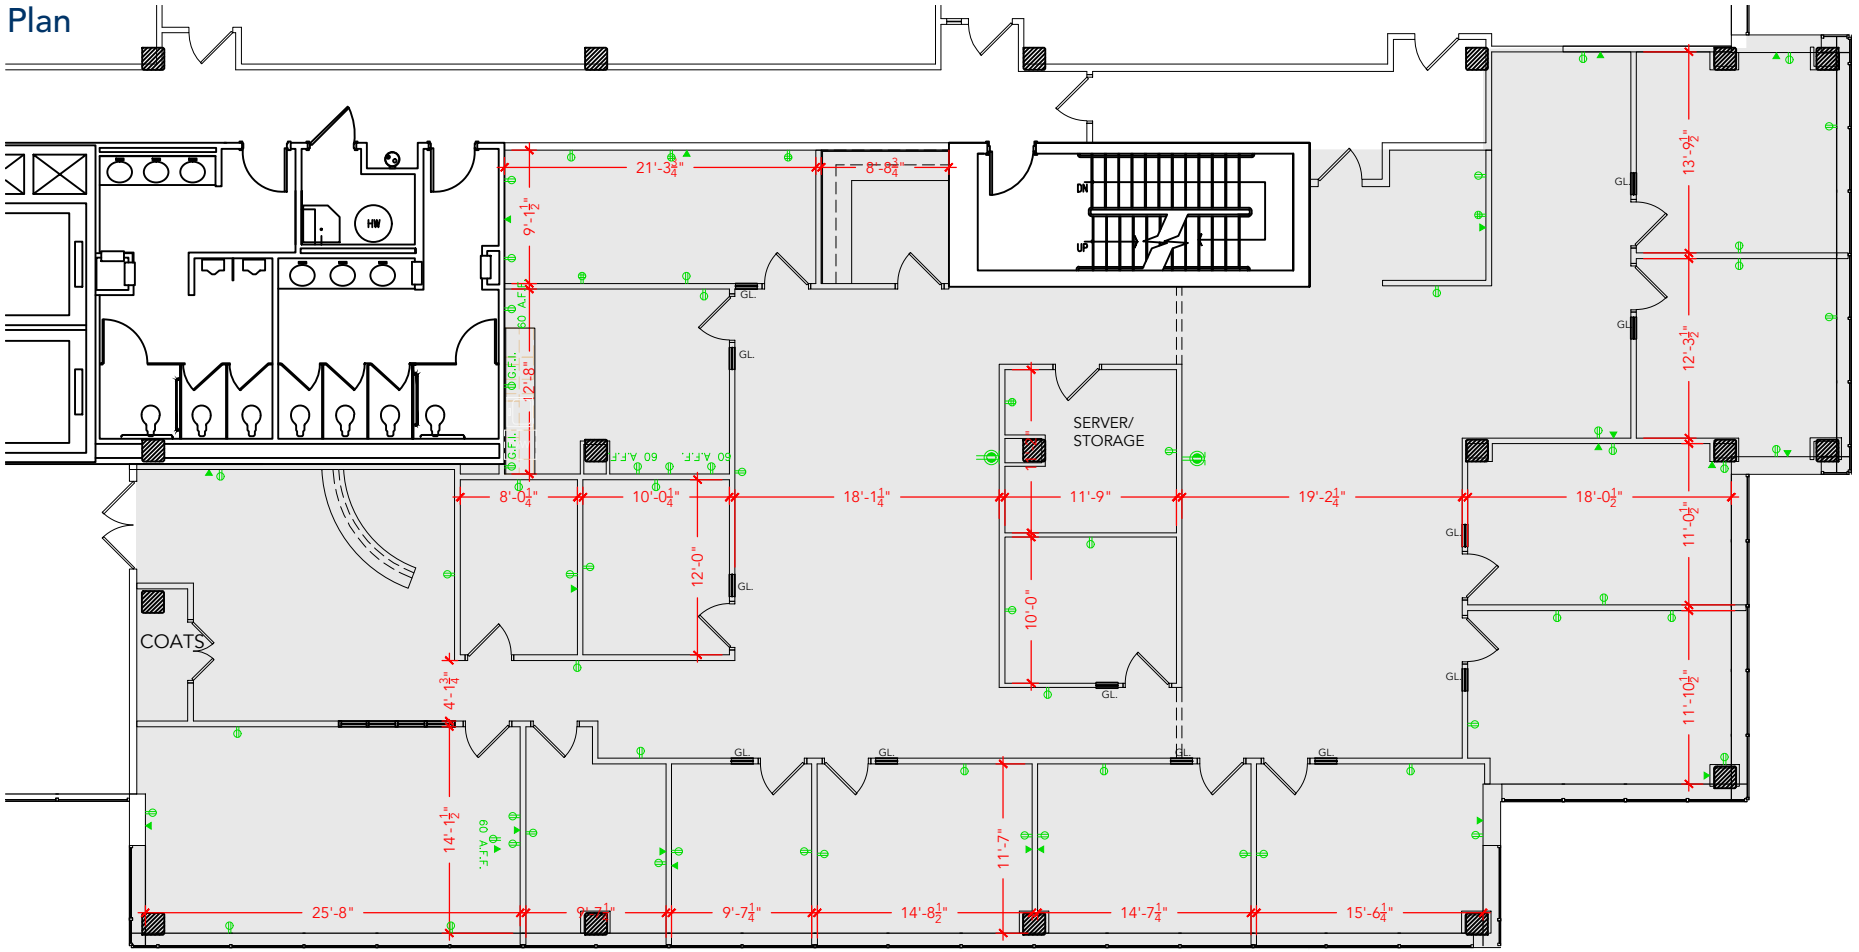

Floor Plan

PLAN NOT TO SCALE - THIS IS NOT A CONSTRUCTION DOCUMENT

DRAWING #: HF3-290 ASBUILT DATE:**02.06.18**