INTERNATIONAL CIRCLE

303 INTERNATIONAL CIRCLE HUNT VALLEY, MD 21030
SUITE 300-310

TOTAL SF AVAILABLE -3,880 RSF (12%

Click to access **3D** model

Key Plan

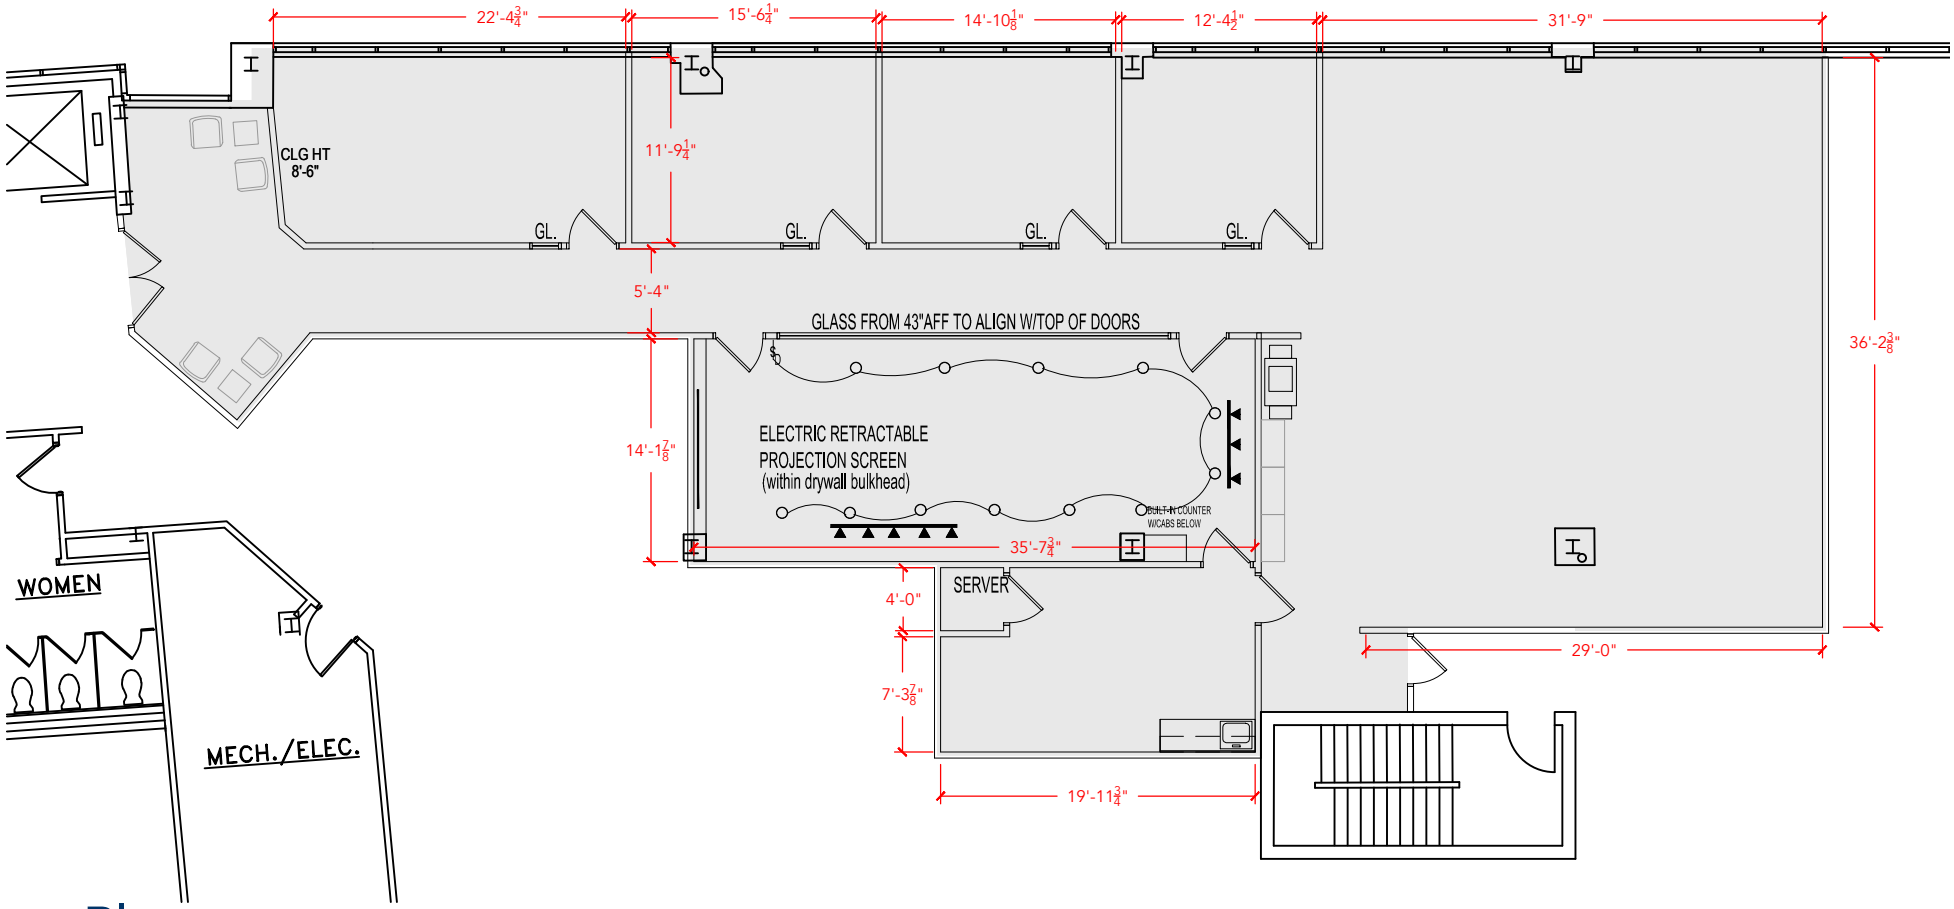

Floor Plan

PLAN NOT TO SCALE - THIS IS NOT A CONSTRUCTION DOCUMENT

DRAWING #: IC1-300-310 ASBUILT DATE:12.09.13