BEACH COMMERCE CENTER

11840 BEACH BOULEVARD, JACKSONVILLE, FL 32246

SUITE 10

merritt PROPERTIES

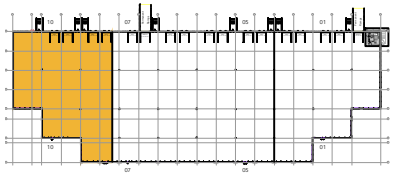

Key Plan

TOTAL SF AVAILABLE -11,234 RSF

OFFICE - 11,234 RSF

WAREHOUSE - 0,0000 RSF

* INCLUDES % OF METER ROOM

Click to access **CADD file**

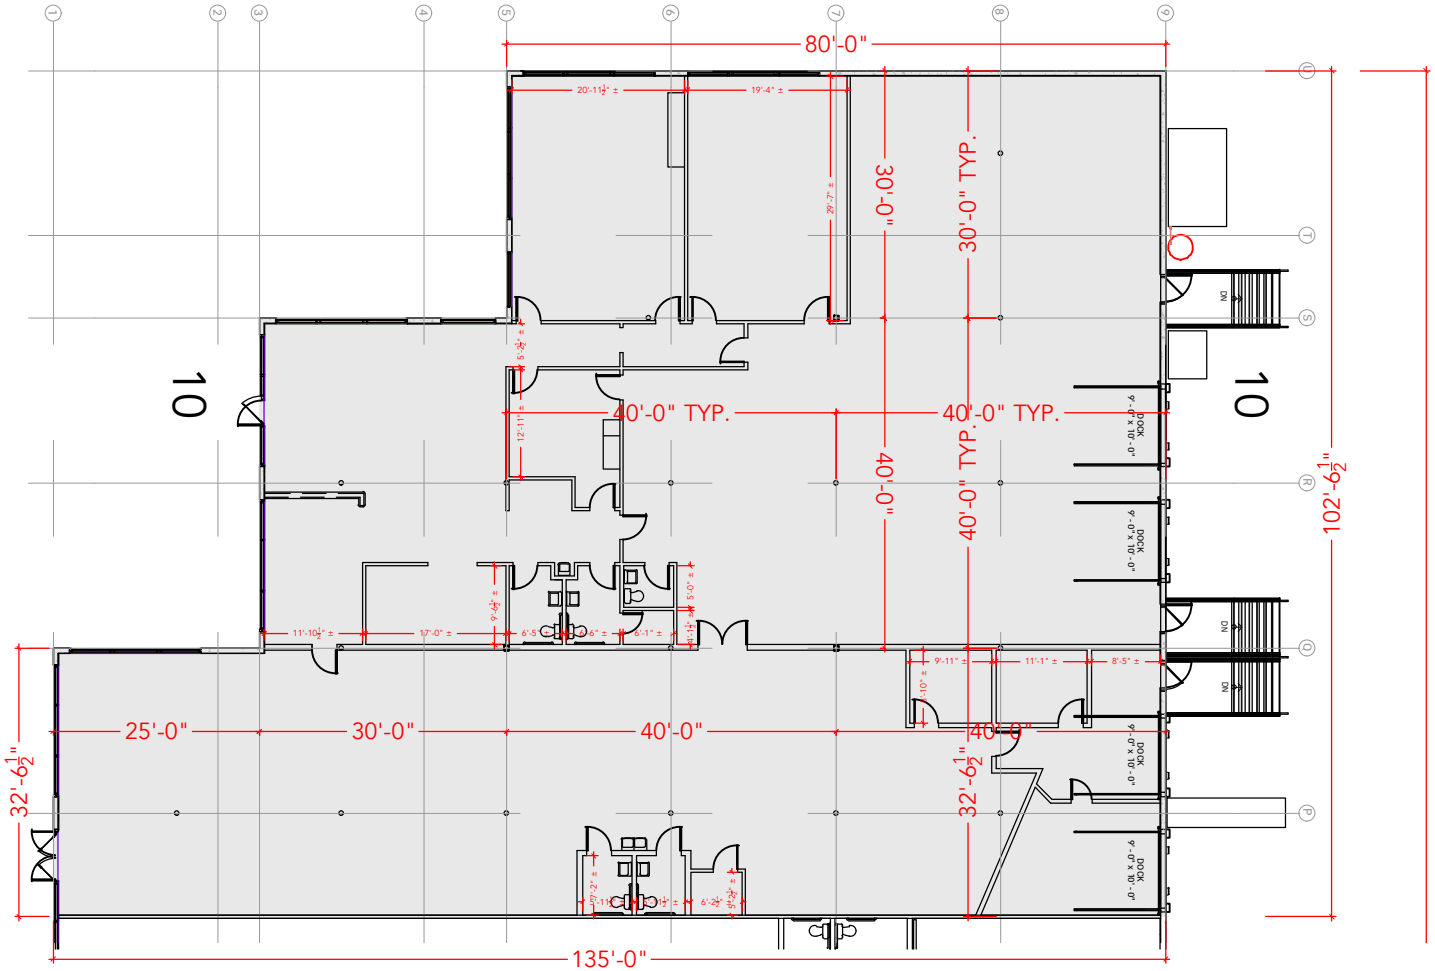

Floor Plan

PLAN NOT TO SCALE - THIS IS NOT A CONSTRUCTION DOCUMENT

DRAWING #: JABB1-10 ASBUILT DATE: **NEEDS TO BE**