CENTER POINT BUSINESS PARK

4810 EXECTUVE PARK COURT, JACKSONVILLE, FL 32216

SUITE 107

merritt PROPERTIES

TOTAL SF AVAILABLE -4,866 SF

OFFICE - 4,866 SF

WAREHOUSE - 0 SF

Click to access **CADD file**

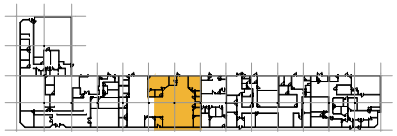

Key Plan

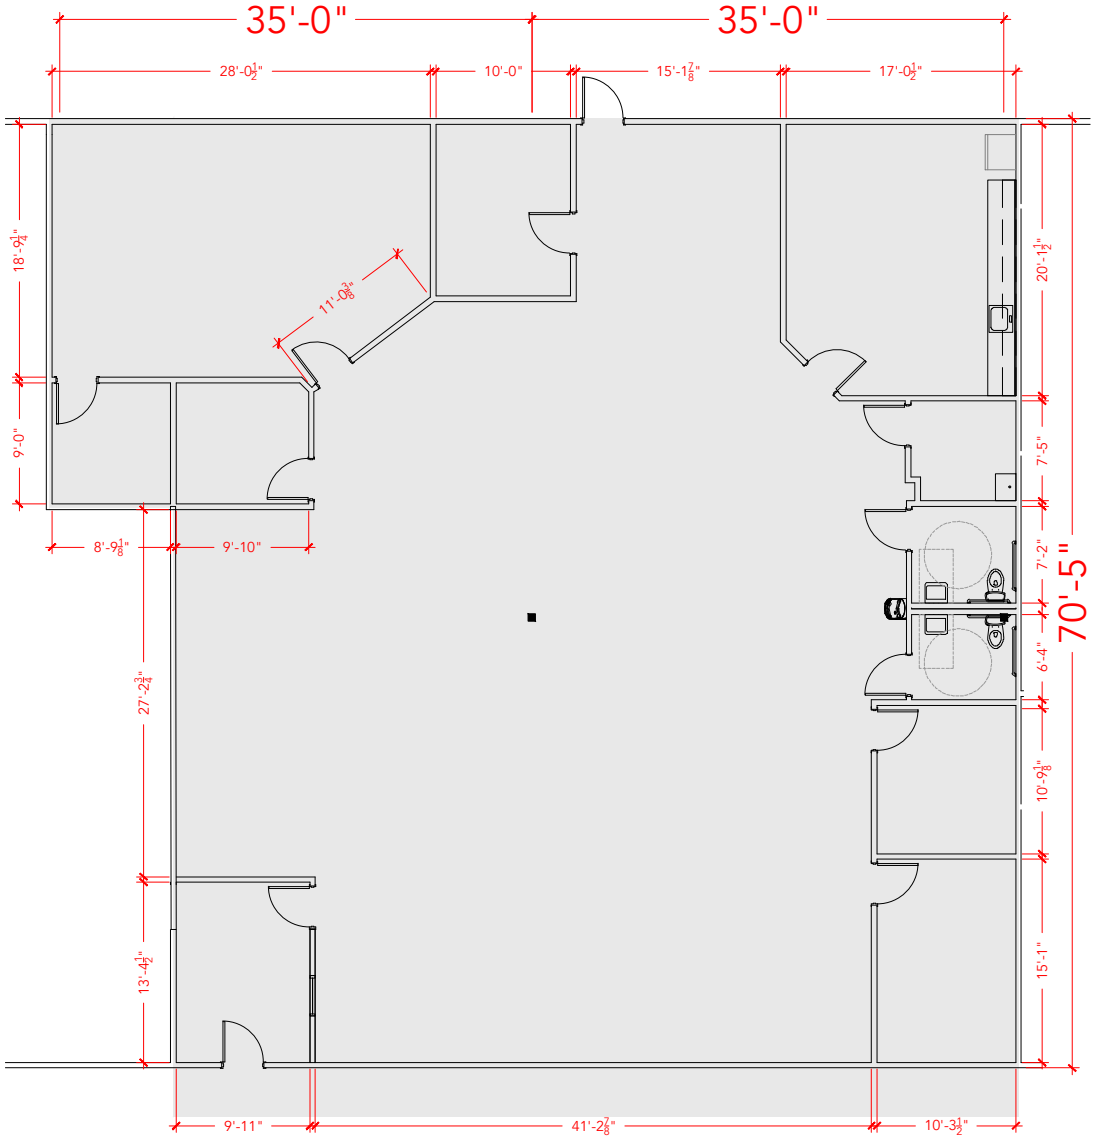

Floor Plan

PLAN NOT TO SCALE - THIS IS NOT A CONSTRUCTION DOCUMENT

DRAWING #: JACP3-BLDG E 4810 107 ASBUILT DATE:NEEDS TO BE