IMESON LANDING BUSINESS PARK

1250 IMESON PARK BLVD, JACKSONVILLE, FL 32218

SUITE 111-113

merritt PROPERTIES

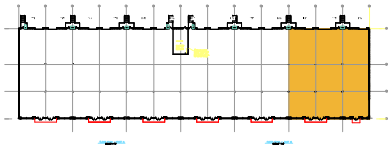

Key Plan

TOTAL SF AVAILABLE -9,108 RSF

OFFICE - 3,746 RSF

WAREHOUSE - 5,362 RSF

Click to access **3D** model

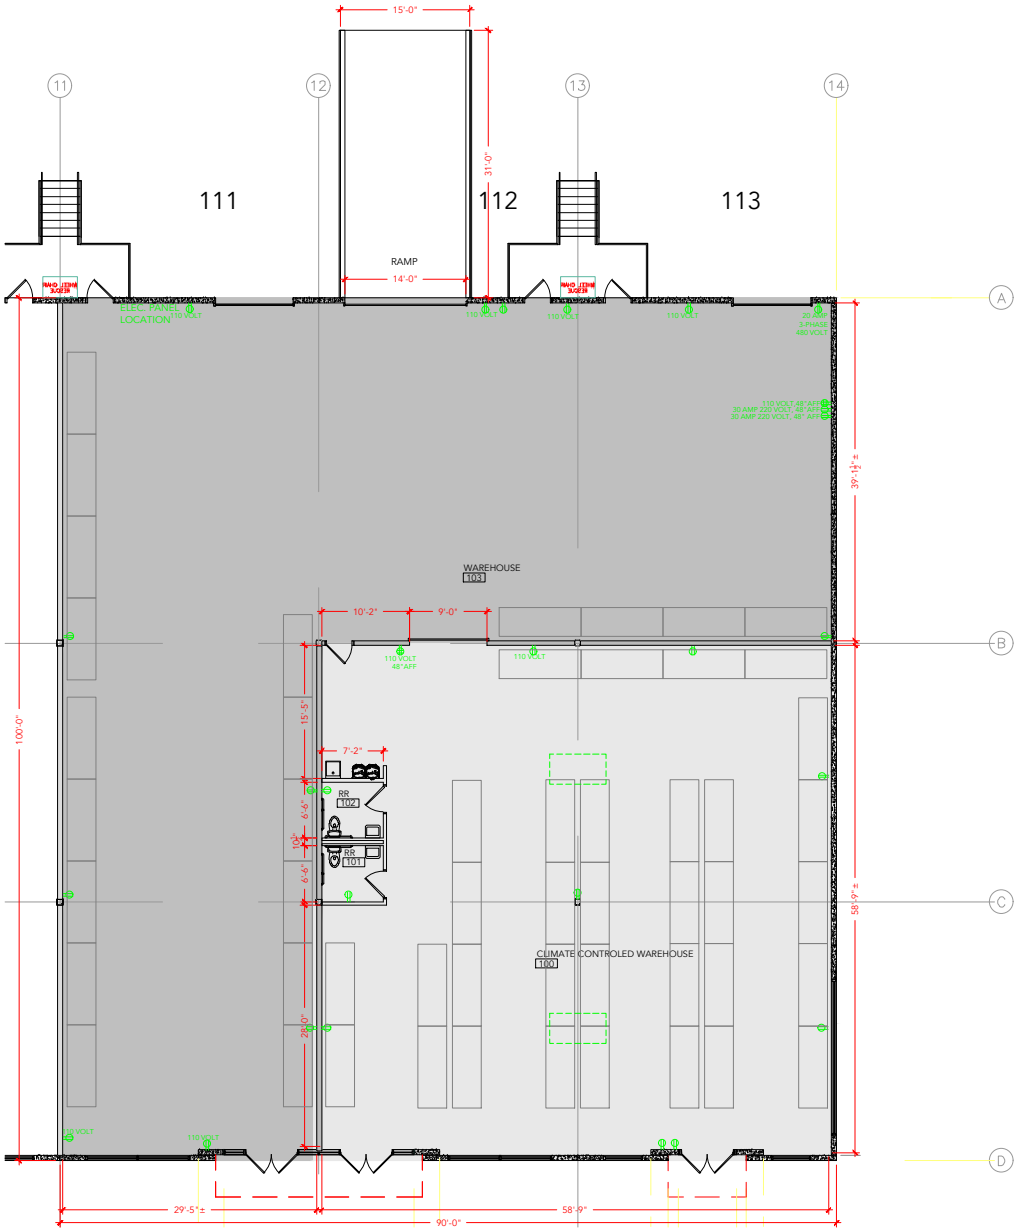

Floor Plan

PLAN NOT TO SCALE - THIS IS NOT A CONSTRUCTION DOCUMENT

DRAWING #: JAIM1-BLDG1-111-113 ASBUILT DATE: **NEEDS TO BE**