IMESON LANDING BUSINESS PARK

1250 IMESON PARK BLVD, JACKSONVILLE, FL 32218

SUITE 401-403

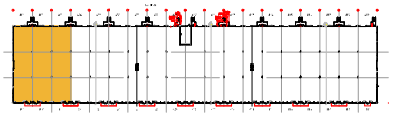

Key Plan

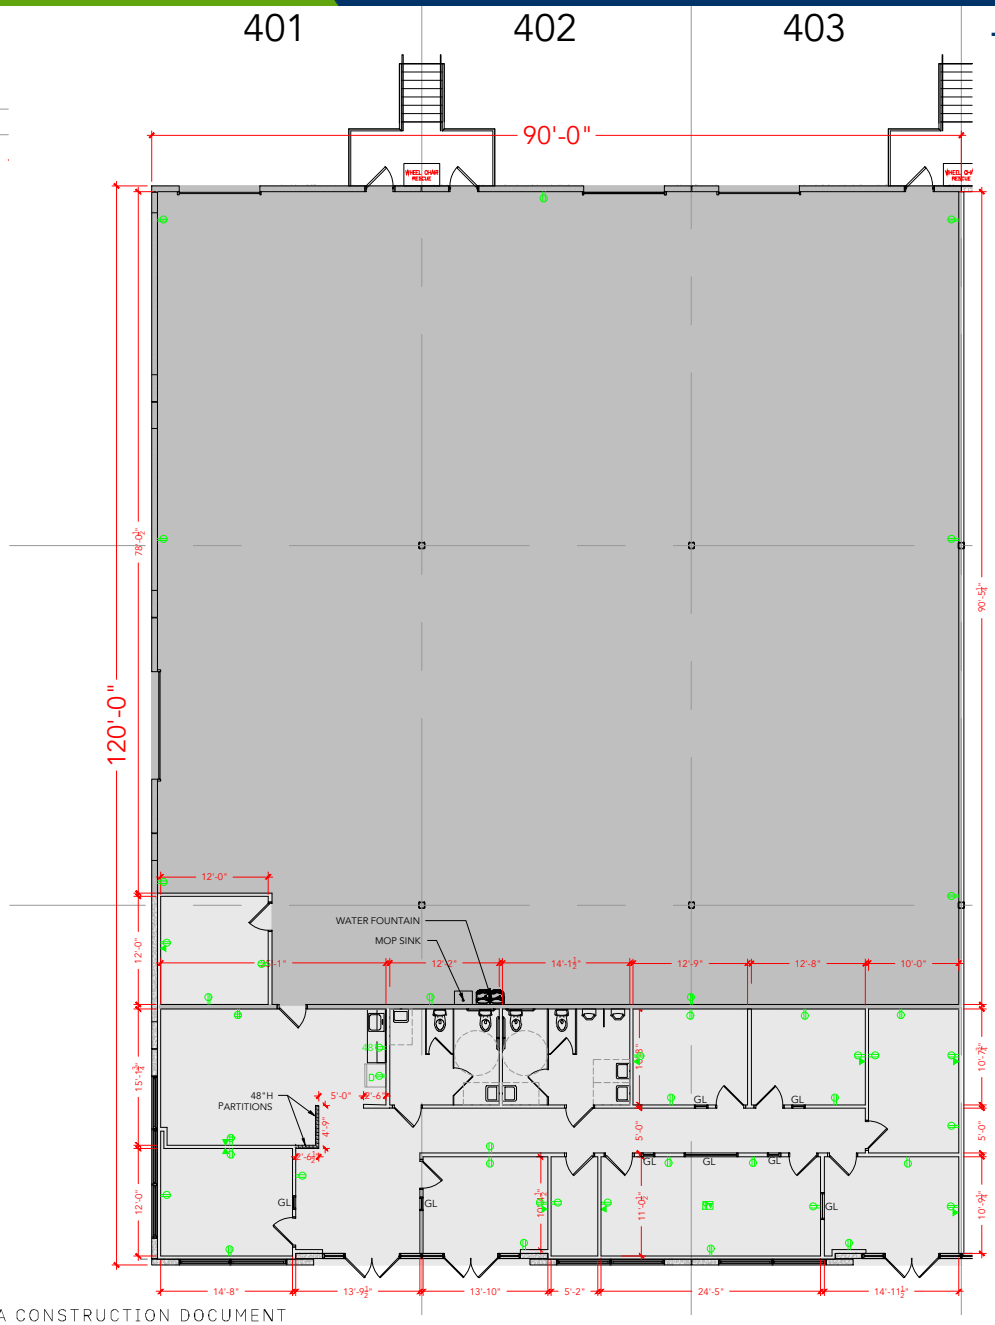

TOTAL SF AVAILABLE - 10,875 RSF

OFFICE - 2,767 RSF

WAREHOUSE - 8,108 RSF

Click to access **3D** model

Floor Plan

PLAN NOT TO SCALE - THIS IS NOT A CONSTRUCTION DOCUMENT

DRAWING #: JAIM4-401-403 ASBUILT DATE: **NEEDS TO BE**