LOUDOUN TECH CENTER 1

21240 RIDGETOP CIRCLE STERLING, VA 20166
SUITE 100

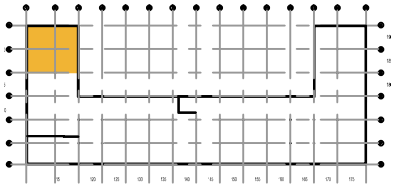

Key Plan

TOTAL SF AVAILABLE - 4,036 RSF

OFFICE - 4,036 RSF
WAREHOUSE - 0,000 SF

* INCLUDES % OF METER ROOM

Click to access 3D model

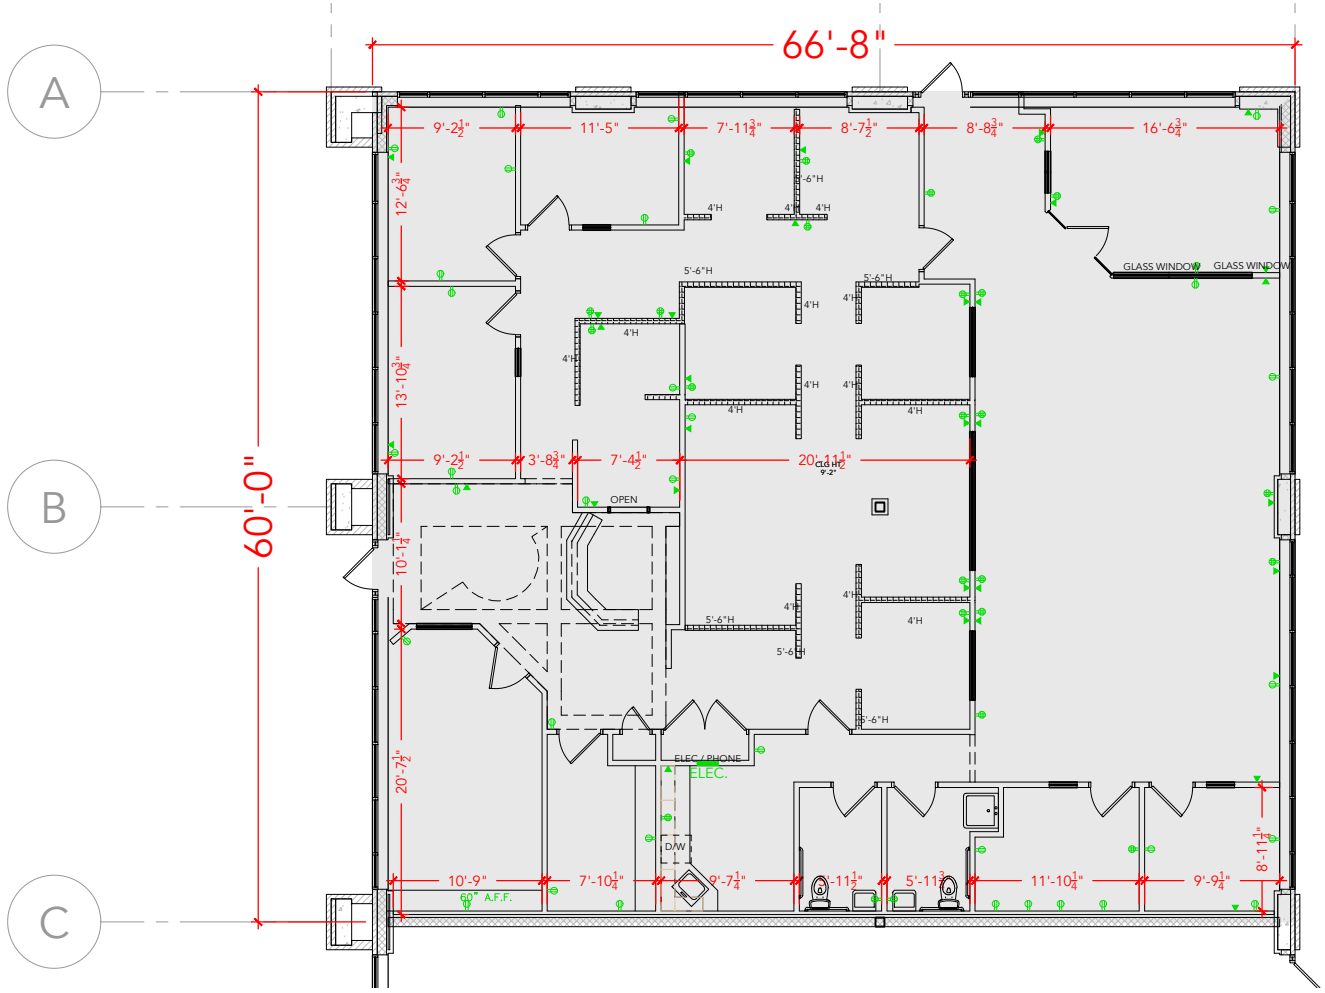

Floor Plan

PLAN NOT TO SCALE - THIS IS NOT A CONSTRUCTION DOCUMENT

DRAWING #: LS1-100 ASBUILT DATE: 03.14.2019