LOUDOUN TECH CENTER 3

21620 RIDGETOP CIRCLE STERLING, VA 20166
SUITE 100-130

merritt PROPERTIES

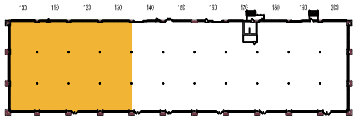

TOTAL SF AVAILABLE - 10,236 RSF

OFFICE - 10,236 SF
WAREHOUSE - 0,000 SF
* INCLUDES % OF METER ROOM
Click to access **3D** model

Key Plan

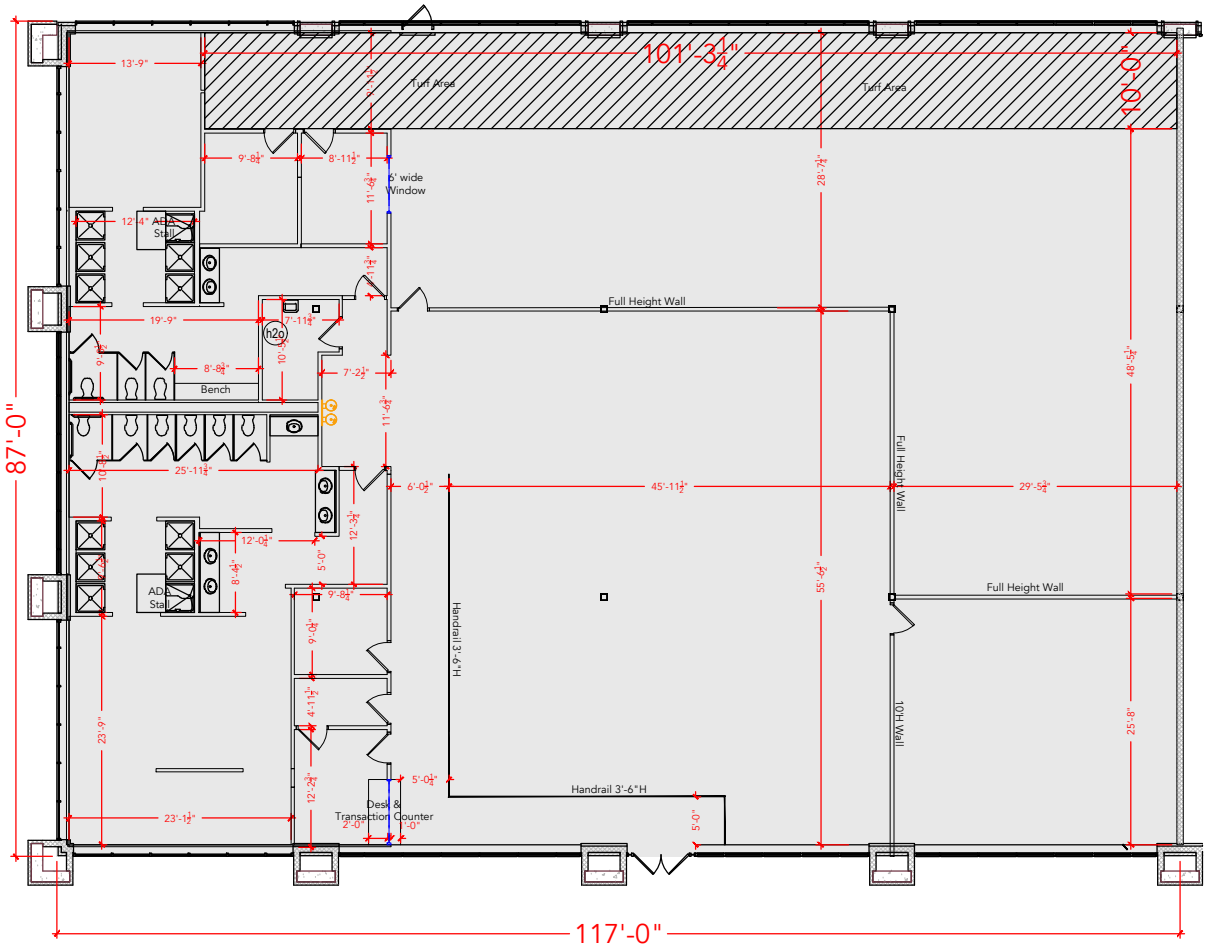

Floor Plan

PLAN NOT TO SCALE - THIS IS NOT A CONSTRUCTION DOCUMENT

DRAWING #: LS2-B3-100- 130 ASBUILT DATE: NEEDS TO BE FIELD VERIFIED