RED RUN BUSINESS PARK

11221 DOLFIELD BLVD OWINGS MILLS, MD 21117

SUITES 112-113F

TOTAL SF AVAILABLE -3,442 RSF

OFFICE - 1,750 RSF

WAREHOUSE - 1,692 RSF

* INCLUDES % OF METER ROOM

Click to access **CADD file**

Key Plan

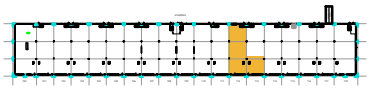

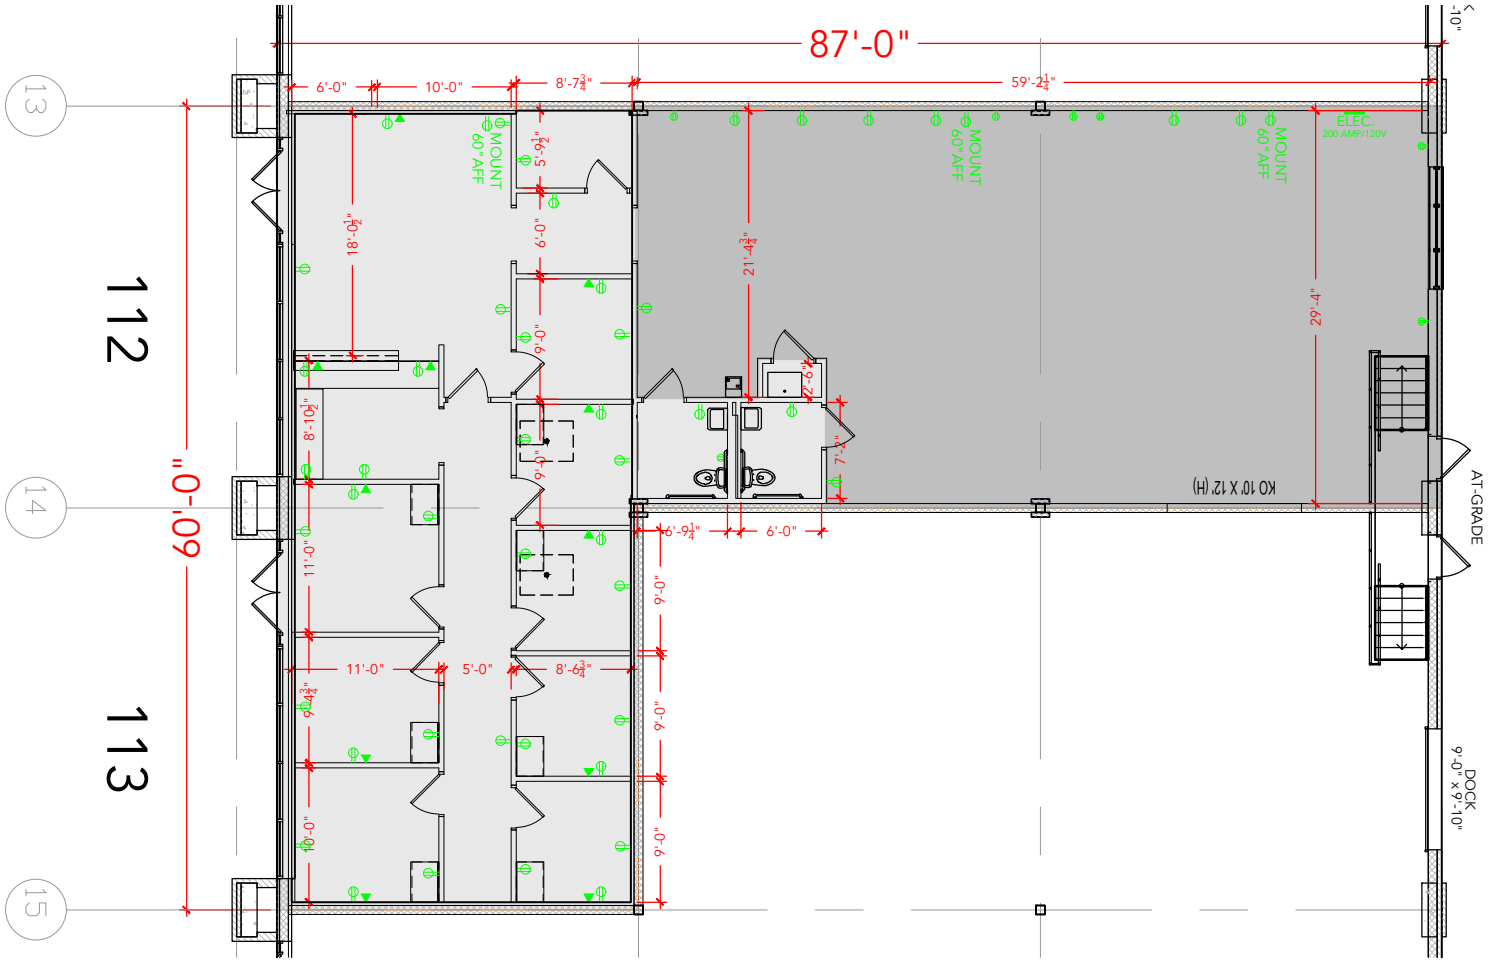

Floor Plan

PLAN NOT TO SCALE - THIS IS NOT A CONSTRUCTION DOCUMENT

DRAWING #: M10-112-113F ASBUILT DATE: 02.13.19