RED RUN BUSINESS PARK

11221 DOLFIELD BLVD OWINGS MILLS, MD 21117
SUITE 113(R)-115(R)

TOTAL SF AVAILABLE -5,715 SF

OFFICE - 997 SF
WAREHOUSE - 4,718 SF

Click to access **CADD file**

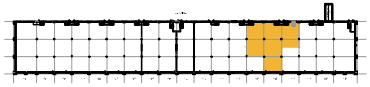

Key Plan

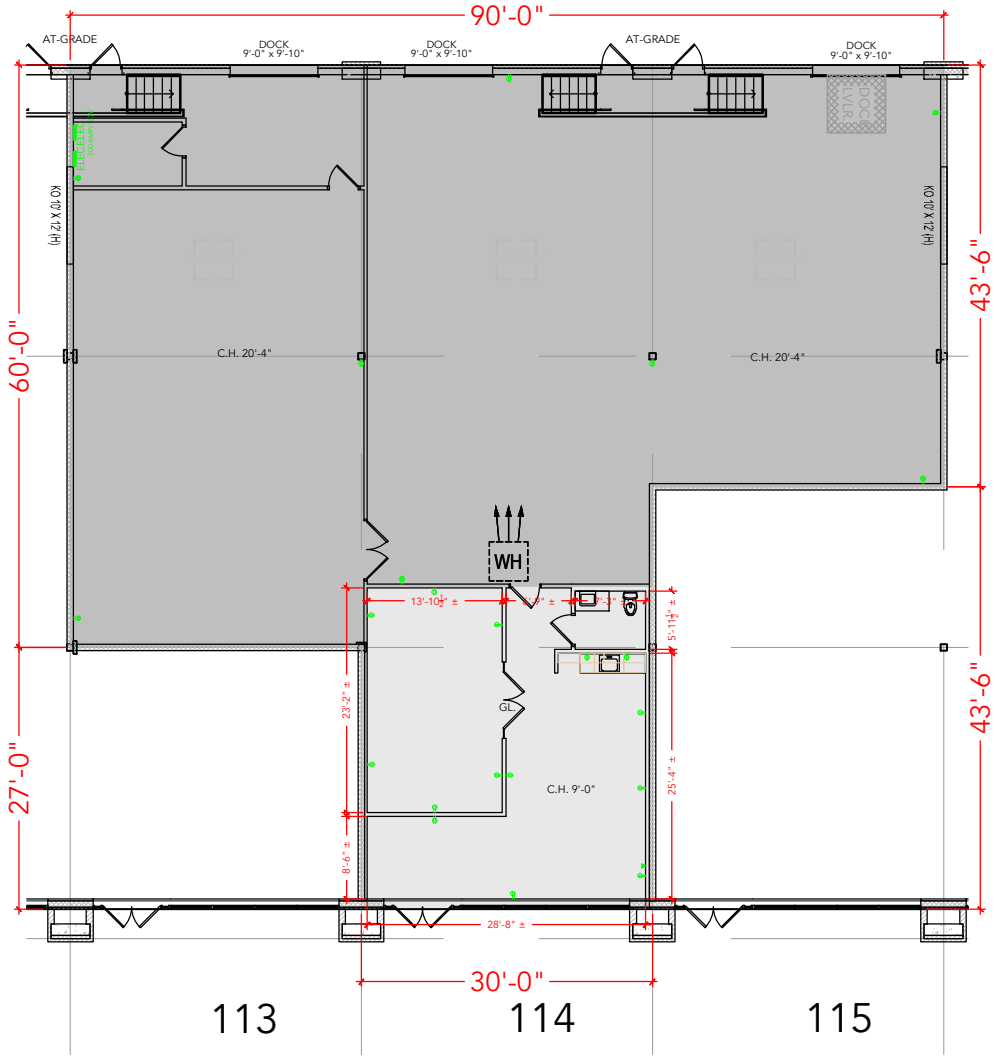

Floor Plan

PLAN NOT TO SCALE - THIS IS NOT A CONSTRUCTION DOCUMENT

DRAWING #: M10-113R-115R ASBUILT DATE: **03.21.25**