MEADOWRIDGE 95 - BUILDING 2

6518 MEADOWRIDGE RD ELKRIDGE, MD 21075

SUITE 100 & 128-142

merritt PROPERTIES

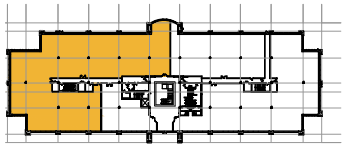

TOTAL SF AVAILABLE -14,479 RSF(16%)

Click to access **CADD file**

Key Plan

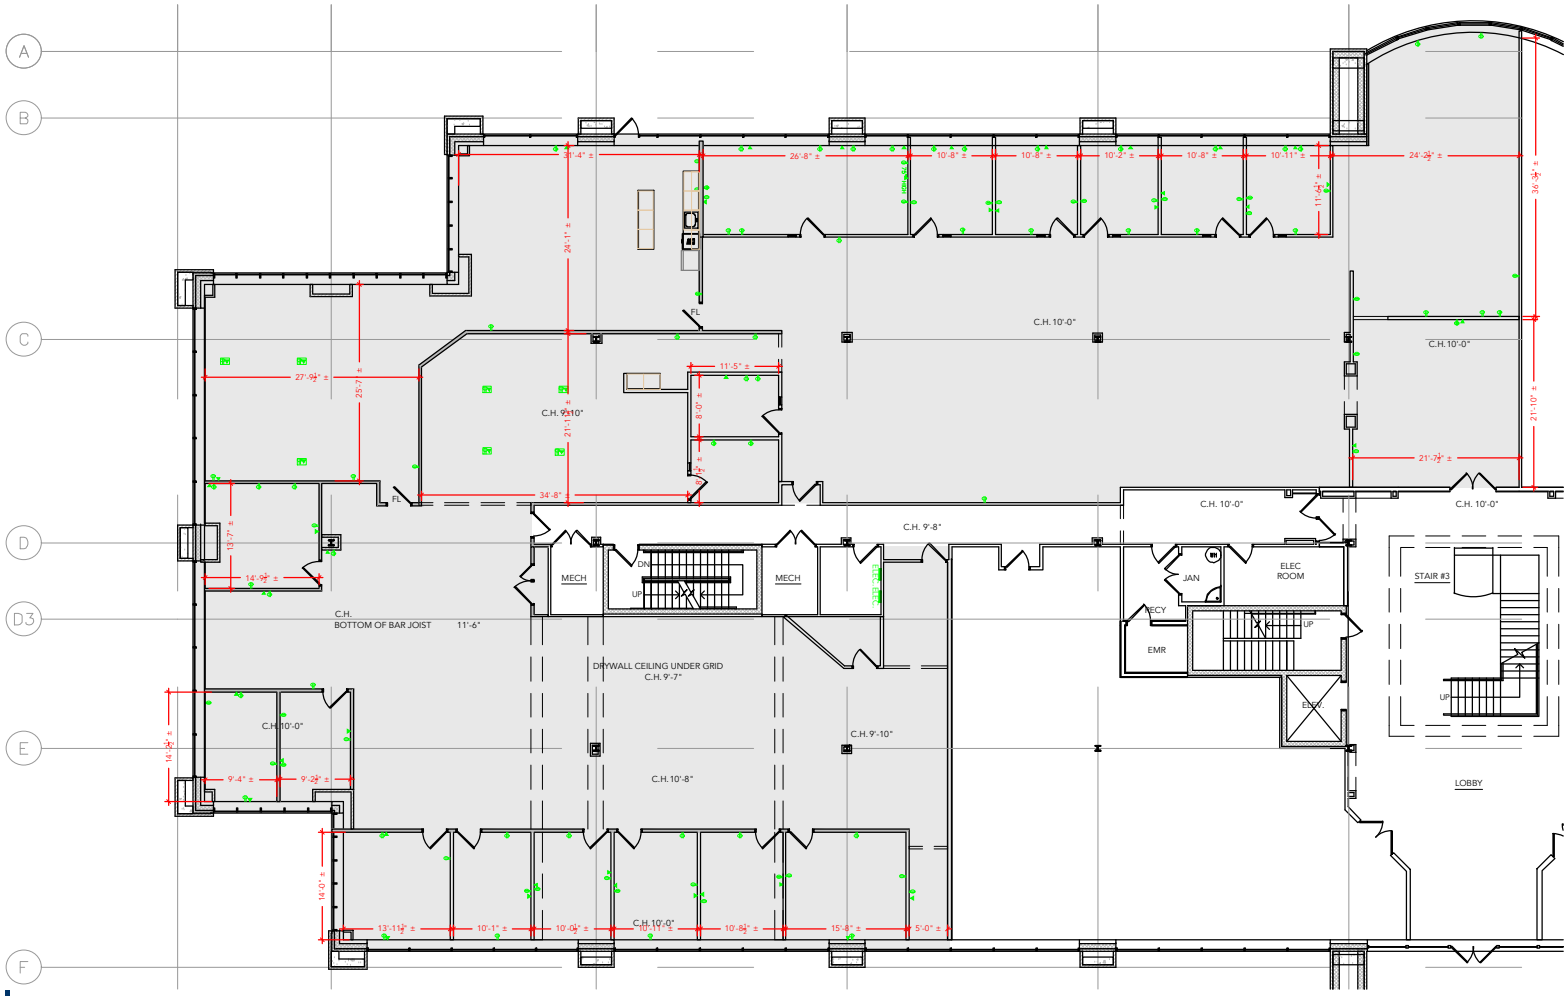

Floor Plan

PLAN NOT TO SCALE - THIS IS NOT A CONSTRUCTION DOCUMENT

DRAWING #: MR2-100 & 128-142 ASBUILT DATE: **03.31.2026**