MEADOWRIDGE 95 - BUILDING 2

6518 MEADOWRIDGE RD ELKRIDGE, MD 21075

SUITE 222-234

merritt PROPERTIES

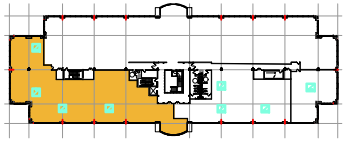

TOTAL SF AVAILABLE - 10,052 RSF(12%)

Click to access **3D** model

Key Plan

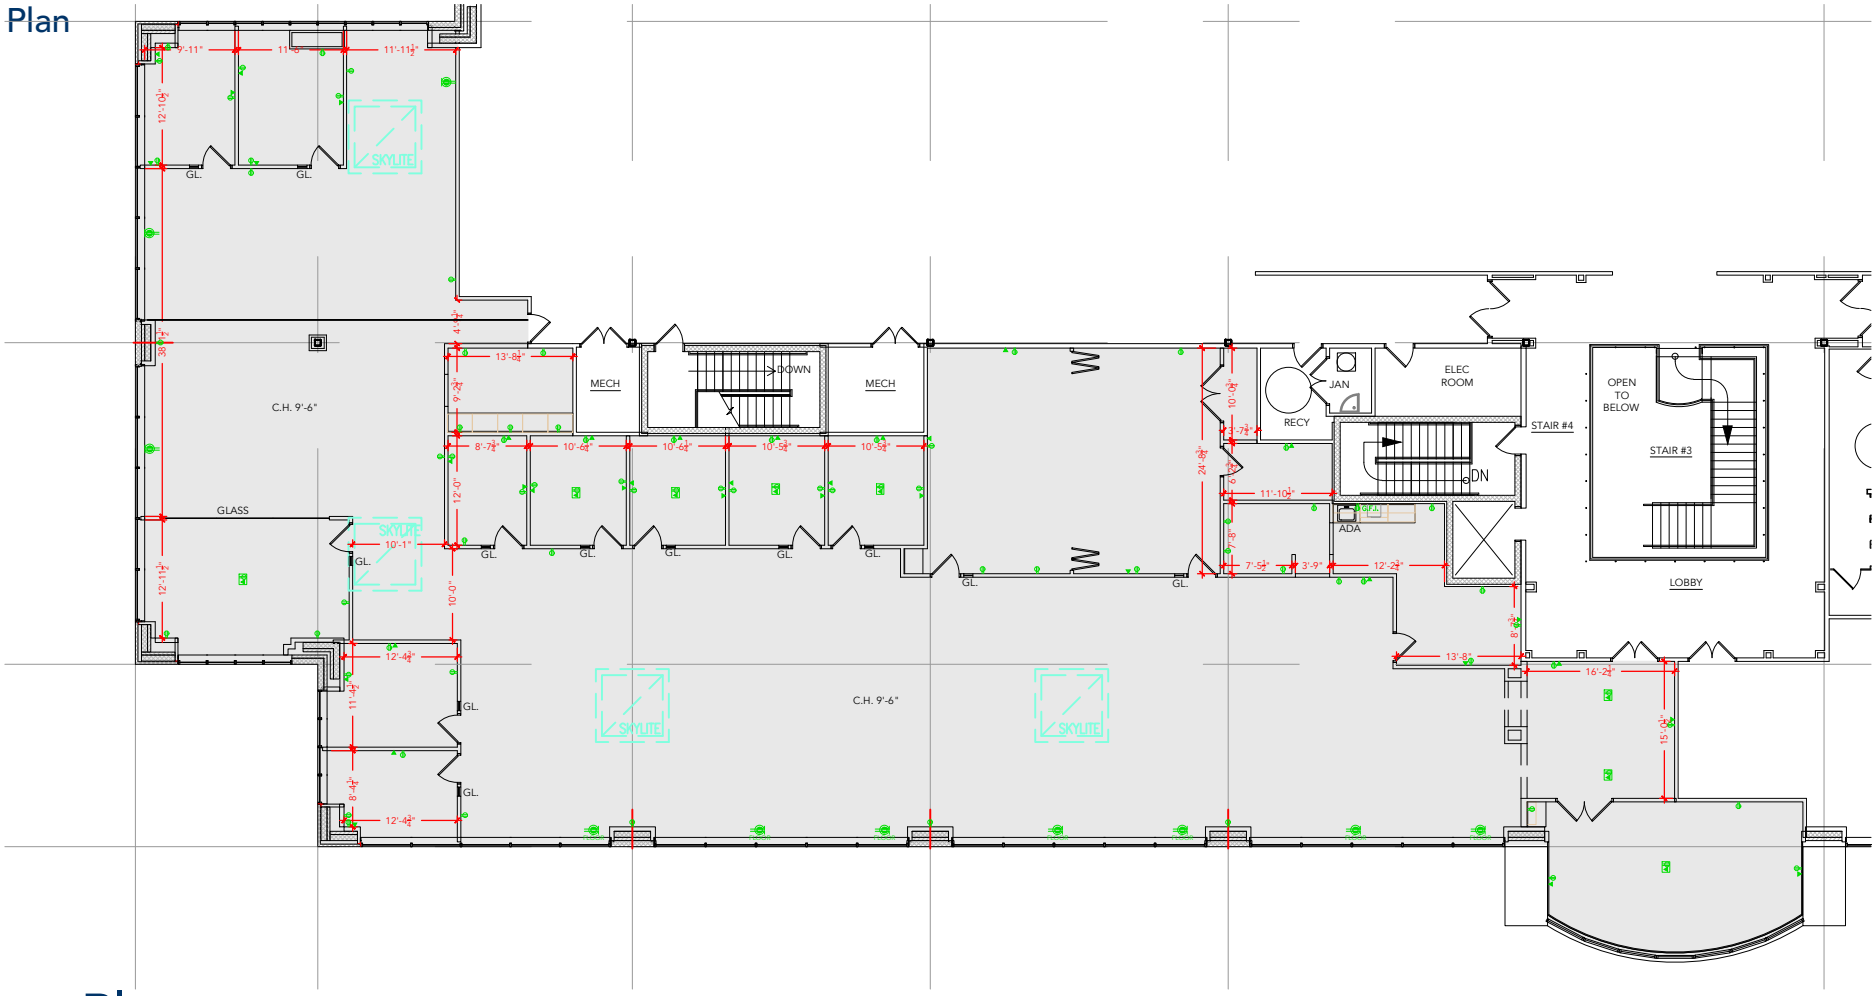

Floor Plan

PLAN NOT TO SCALE - THIS IS NOT A CONSTRUCTION DOCUMENT

DRAWING #: MR2-222-234 ASBUILT DATE: **08.11.21**