MEADOWRIDGE 95 - BUILDING 3

6514 MEADOWRIDGE ROAD, ELKRIDGE, MD 21075

SUITE 100-195

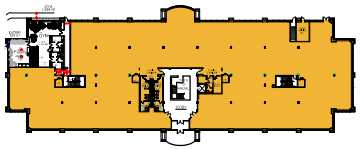

TOTAL SF AVAILABLE -32,734 RSF(12%)

FULL FLOOR USER - 32,734 RSF (12%)

MULTI TENANT - 30,974 RSF(16%)

Click to access **3D** model

Key Plan

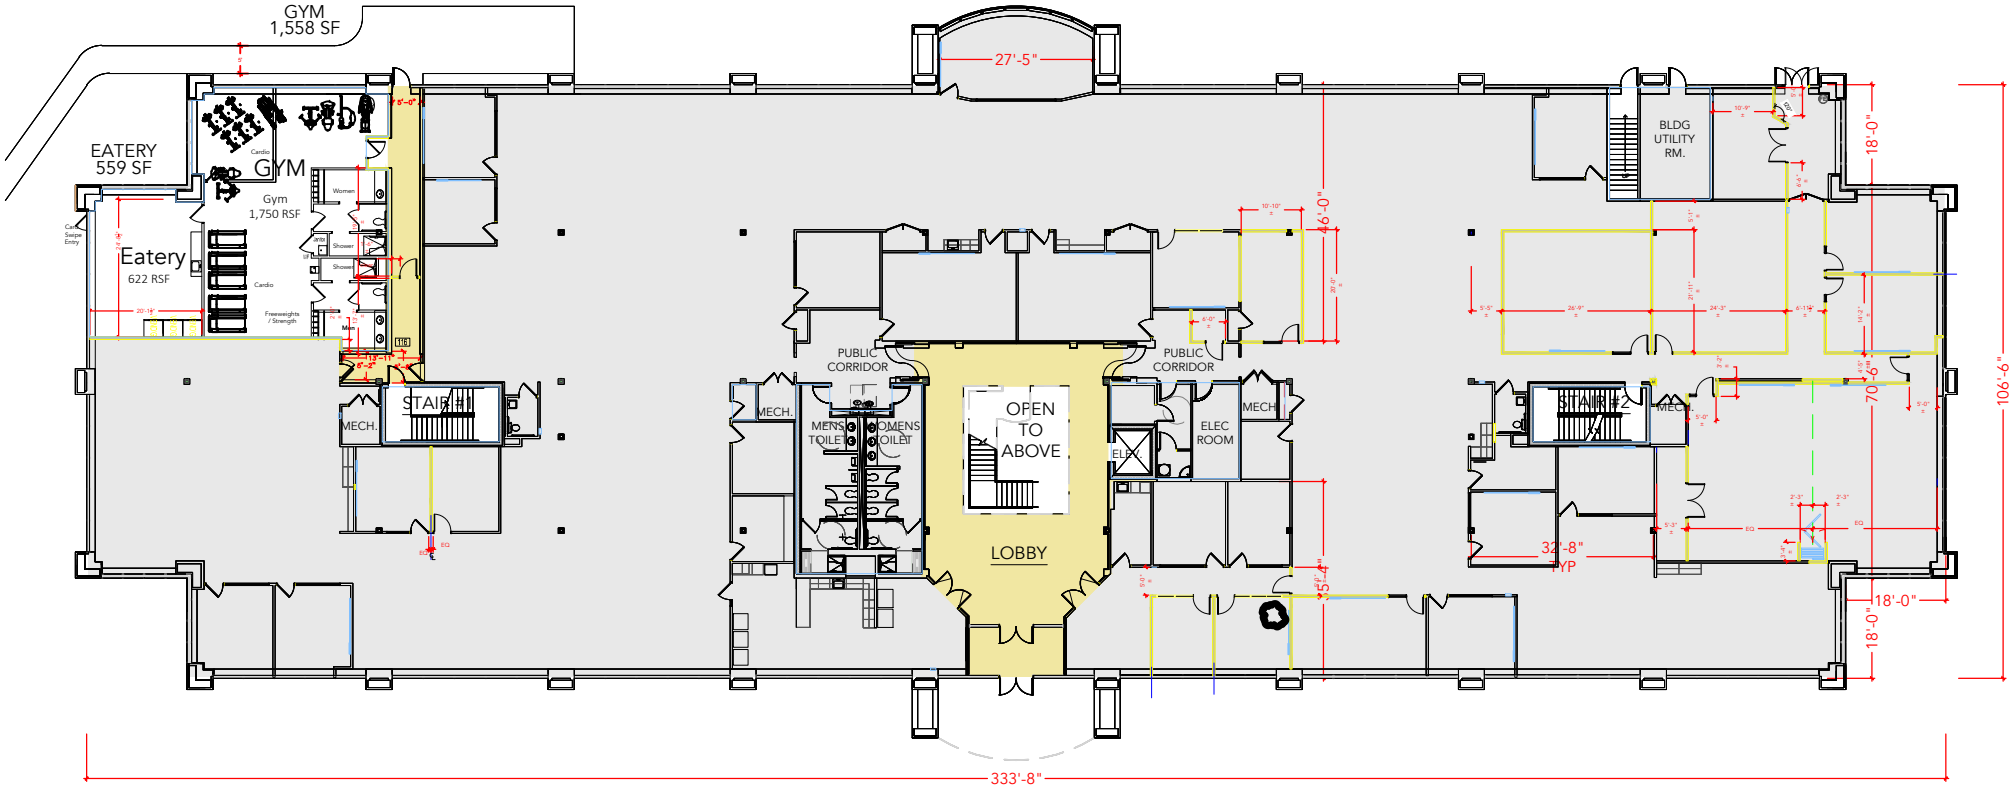

Floor Plan

PLAN NOT TO SCALE - THIS IS NOT A CONSTRUCTION DOCUMENT

DRAWING #: MR3-100-195 ASBUILT DATE: **NEEDS TO BE**

MEADOWRIDGE 95 - BUILDING 3

6514 MEADOWRIDGE ROAD, ELKRIDGE, MD 21075

SUITE 100-195

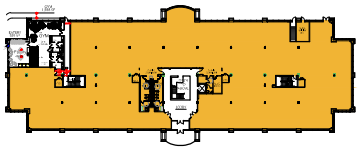

TOTAL SF AVAILABLE -32,734 RSF(12%)

FULL FLOOR USER - 32,734 RSF (12%)

MULTI TENANT - 30,974 RSF(16%)

Click to access **3D** model

Key Plan

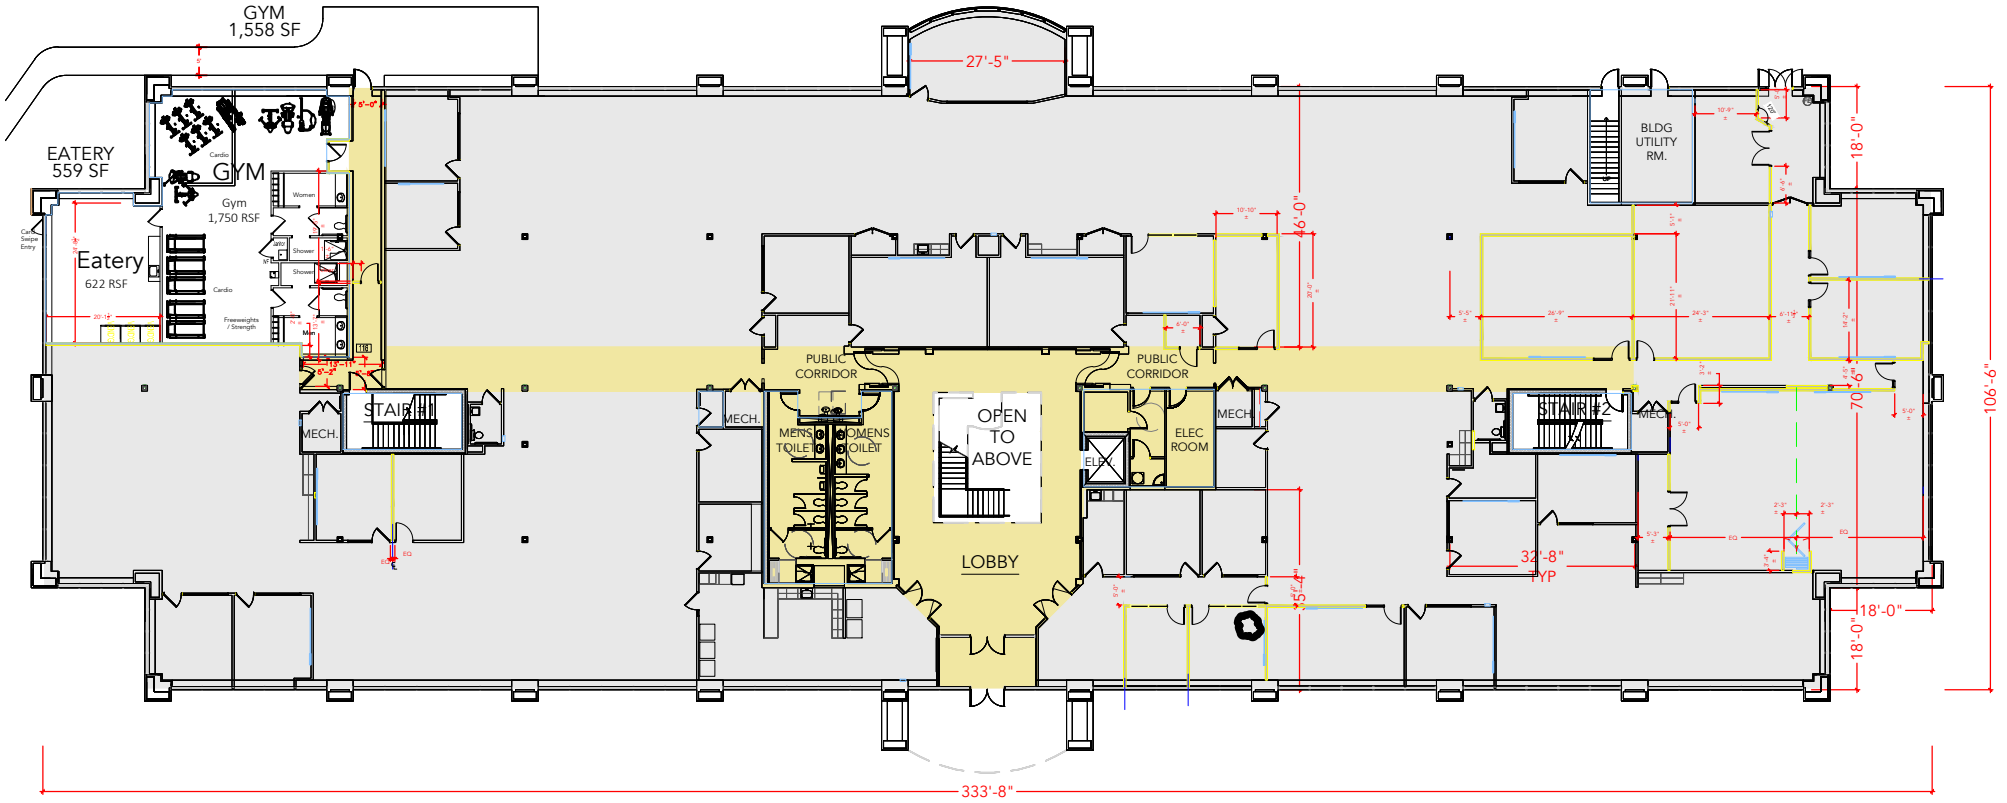

Floor Plan

PLAN NOT TO SCALE - THIS IS NOT A CONSTRUCTION DOCUMENT

DRAWING #: MR3-100-195 ASBUILT DATE: **NEEDS TO BE**

MEADOWRIDGE 95 - BUILDING 3

6514 MEADOWRIDGE ROAD, ELKRIDGE, MD 21075

SUITE 100-195

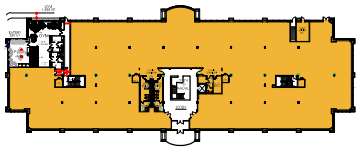

TOTAL SF AVAILABLE -32,734 RSF(12%)

FULL FLOOR USER - 32,734 RSF (12%)

MULTI TENANT - 30,974 RSF(16%)

Click to access **3D** model

Key Plan

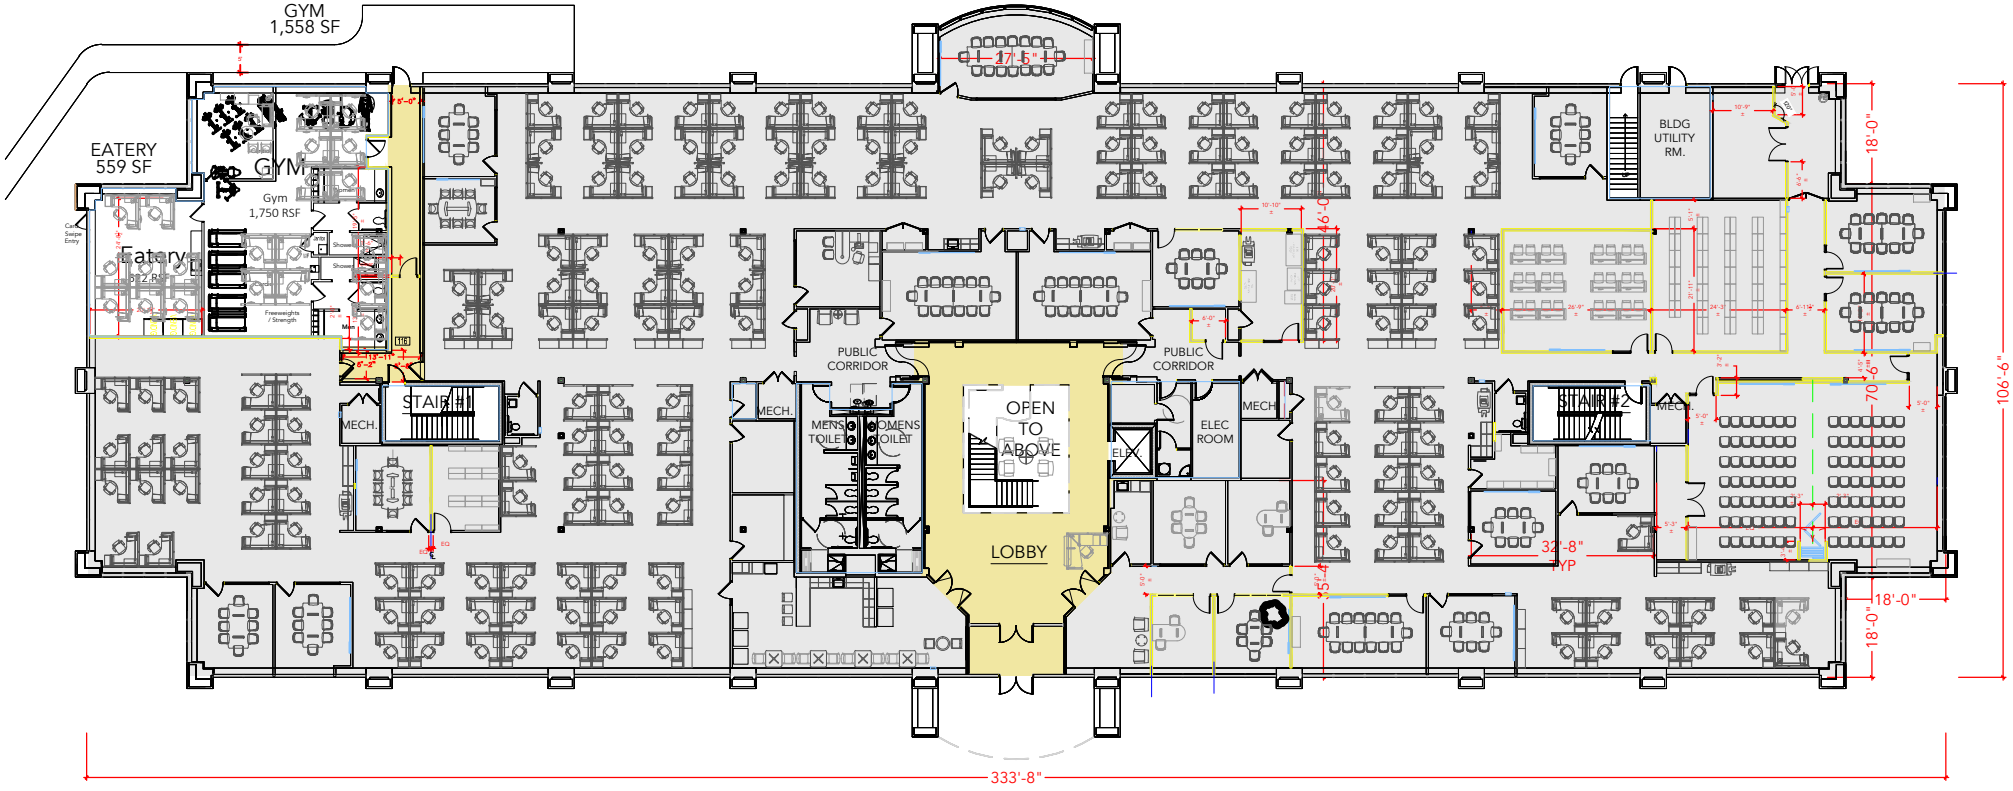

Floor Plan

PLAN NOT TO SCALE - THIS IS NOT A CONSTRUCTION DOCUMENT

DRAWING #: MR3-100-195 ASBUILT DATE: **NEEDS TO BE**