RESEARCH PARK - BUILDING 2

5523 RESEARCH PARK DR. CATONSVILLE, MD 21228
SUITE 230

TOTAL SF AVAILABLE - 4,218 RSF(12%)

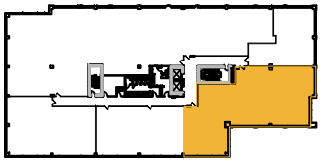

Key Plan

Click to access **3D** model

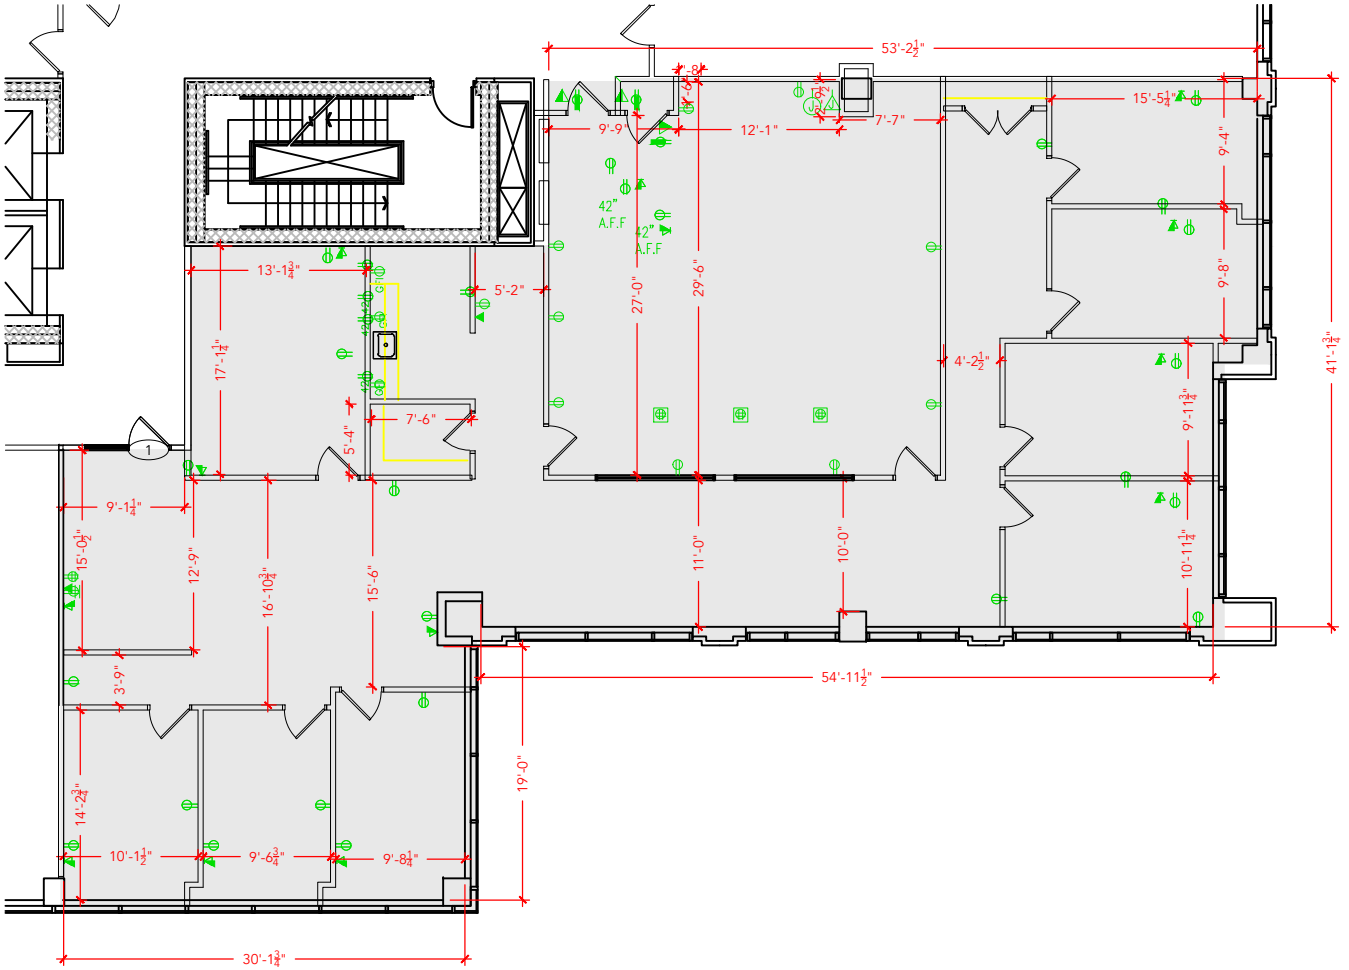

Floor Plan

PLAN NOT TO SCALE - THIS IS NOT A CONSTRUCTION DOCUMENT

DRAWING #: RP2-220-230 ASBUILT DATE:**NEEDS TO BE**