RESEARCH PARK - BUILDING 2

5523 RESEARCH PARK DR. CATONSVILLE, MD 21228

SUITE 310-370

TOTAL SF AVAILABLE - 17,058 RSF(16%)

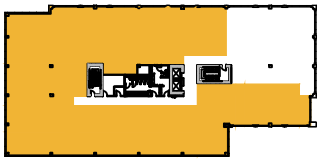

Key Plan

Click to access**3D** model

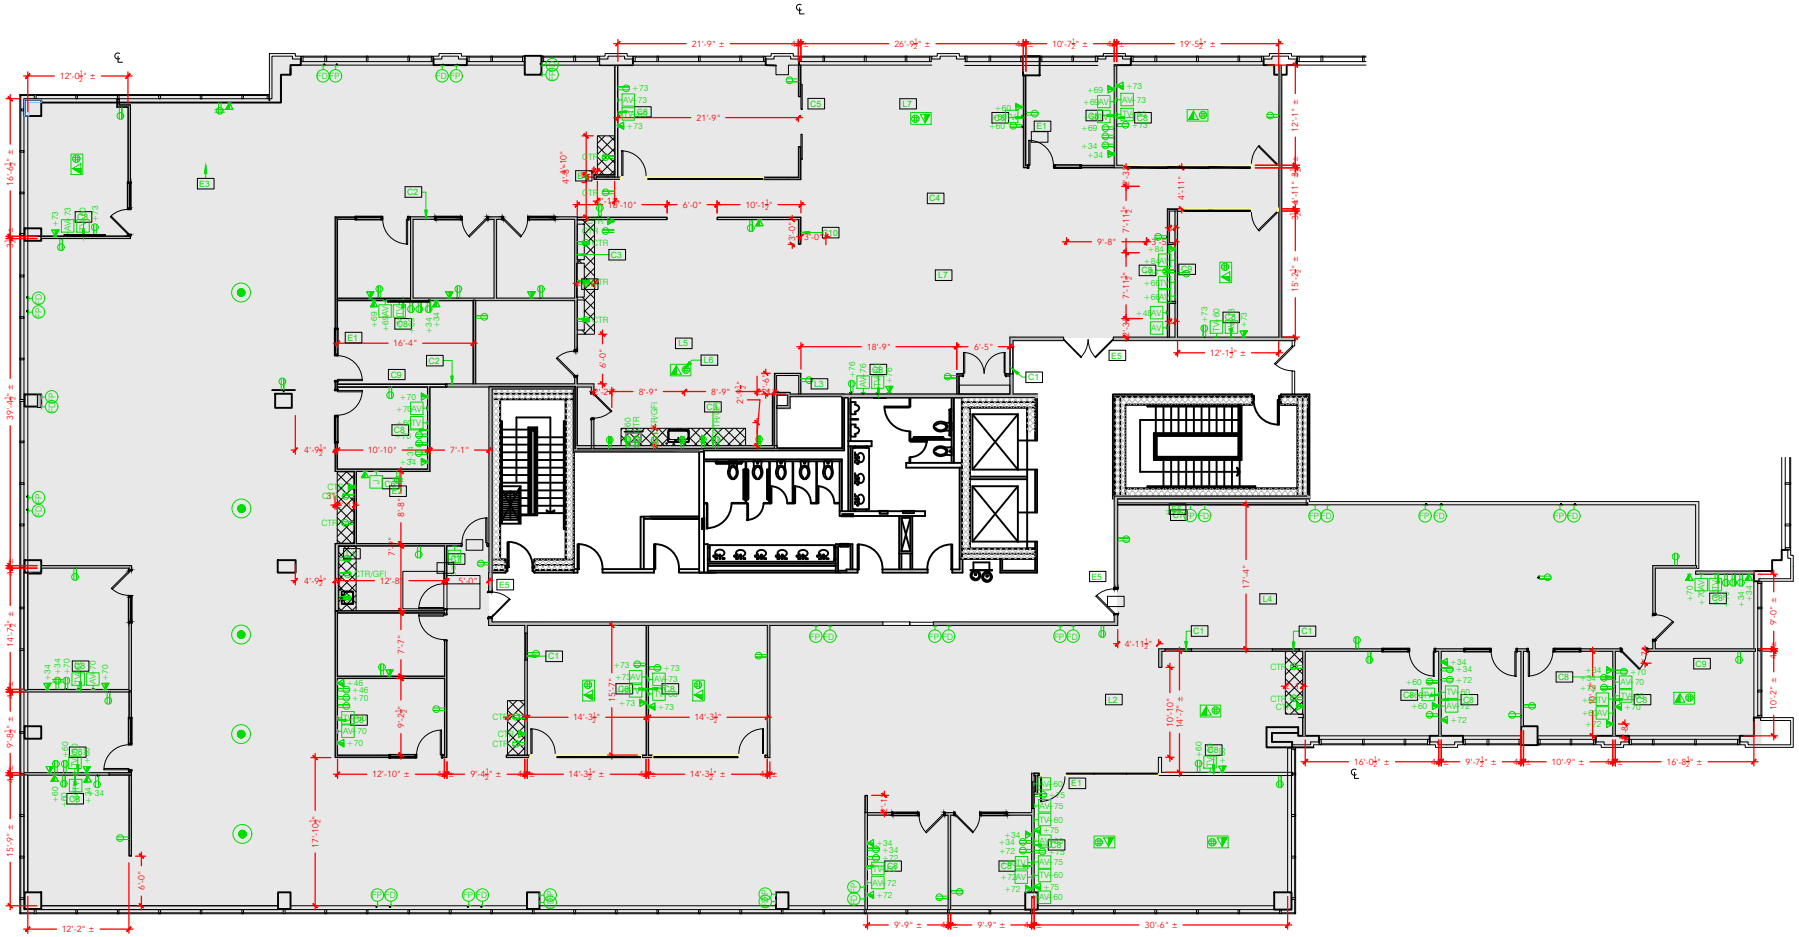

Floor Plan

PLAN NOT TO SCALE - THIS IS NOT A CONSTRUCTION DOCUMENT

DRAWING #: RP2-310-370 ASBUILT DATE: **03.05.2020**