OWINGS MILLS CORPORATE CAMPUS

10045 RED RUN BLVD OWINGS MILLS, MD 21117

SUITE 300

merritt PROPERTIES

Key Plan

TOTAL SF AVAILABLE - 2,883 RSF (12%)

Click to access **CADD file**

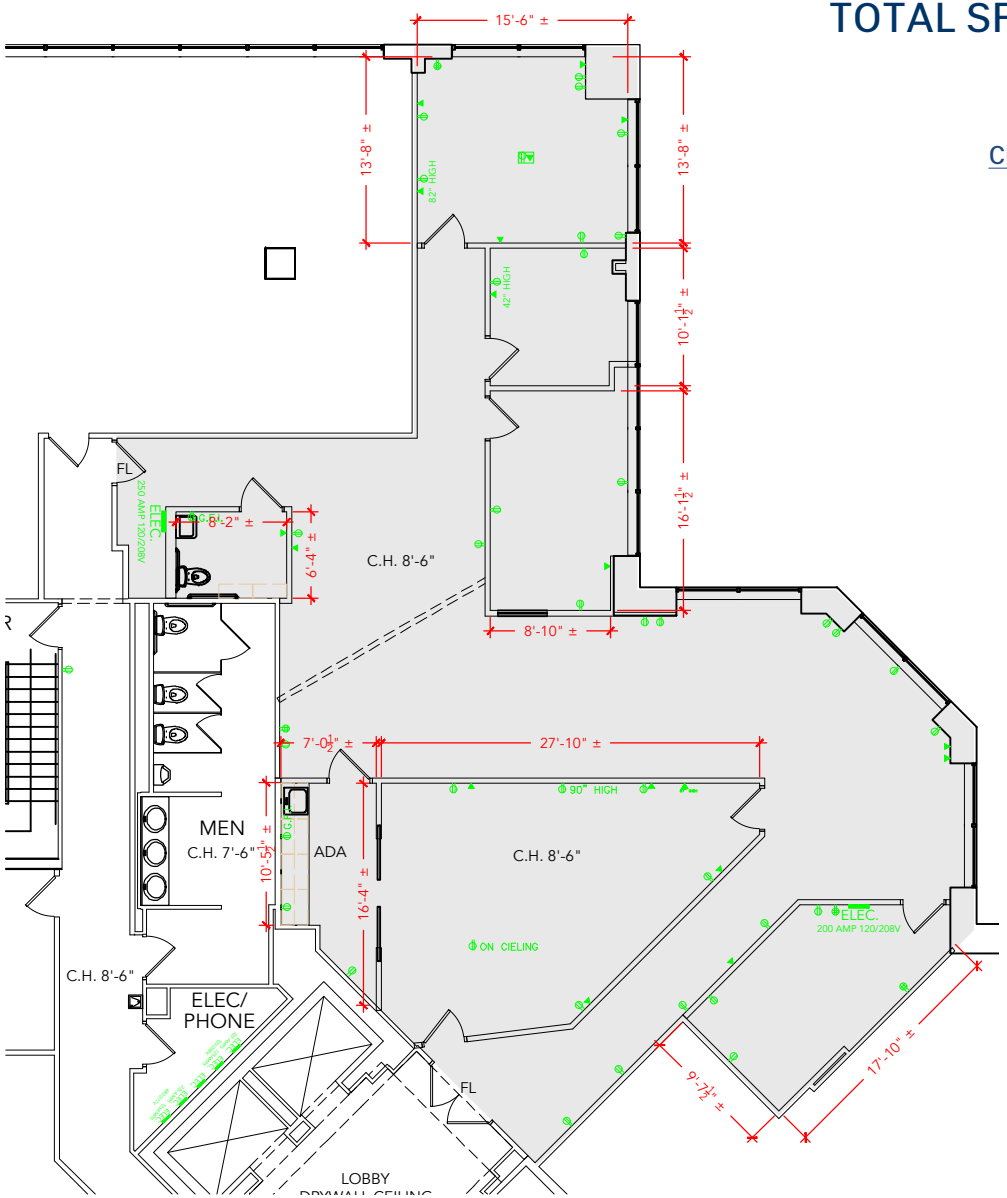

Floor Plan

PLAN NOT TO SCALE - THIS IS NOT A CONSTRUCTION DOCUMENT

DRAWING #: RR1-300 ASBUILT DATE: **09.17.2025**