OWINGS MILLS CORPORATE CAMPUS

10045 RED RUN BLVD OWINGS MILLS, MD 21117

SUITE 350

merritt PROPERTIES

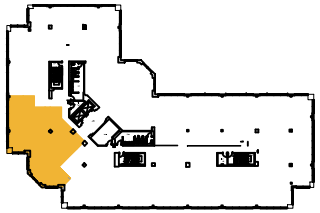

Key Plan

TOTAL SF AVAILABLE - 2,640 RSF(12%)

Click to access **3D** model

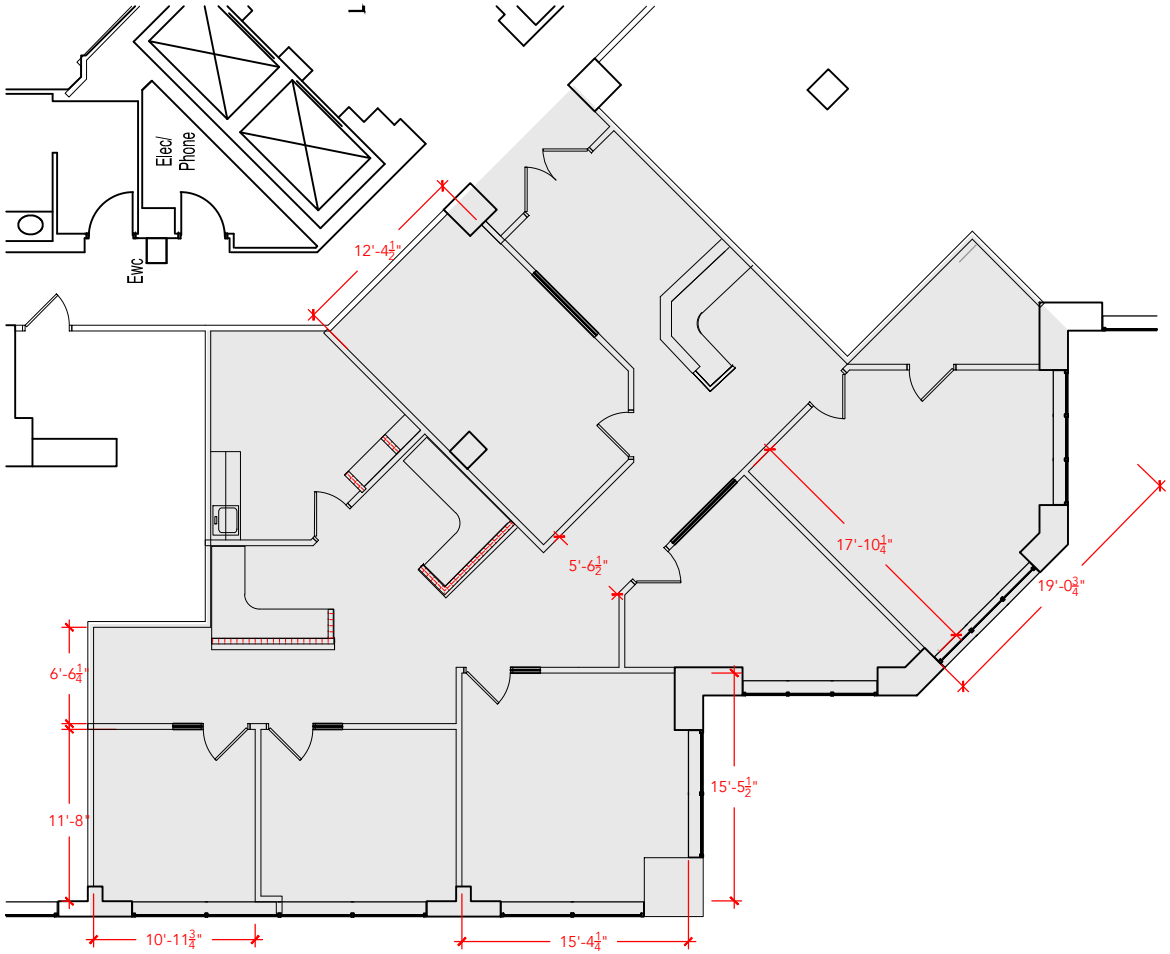

Floor Plan

PLAN NOT TO SCALE - THIS IS NOT A CONSTRUCTION DOCUMENT

DRAWING #: RR1-350 ASBUILT DATE: **NEEDS TO BE**