230 SCHILLING CIRCLE

230 SCHILLING CIRCLE, HUNT VALLEY, MD 21031
SUITE 200-210

TOTAL SF AVAILABLE -6,145 RSF(12%)

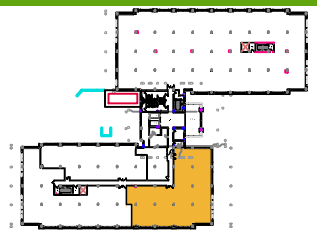

Key Plan

Click to access **CADD file**

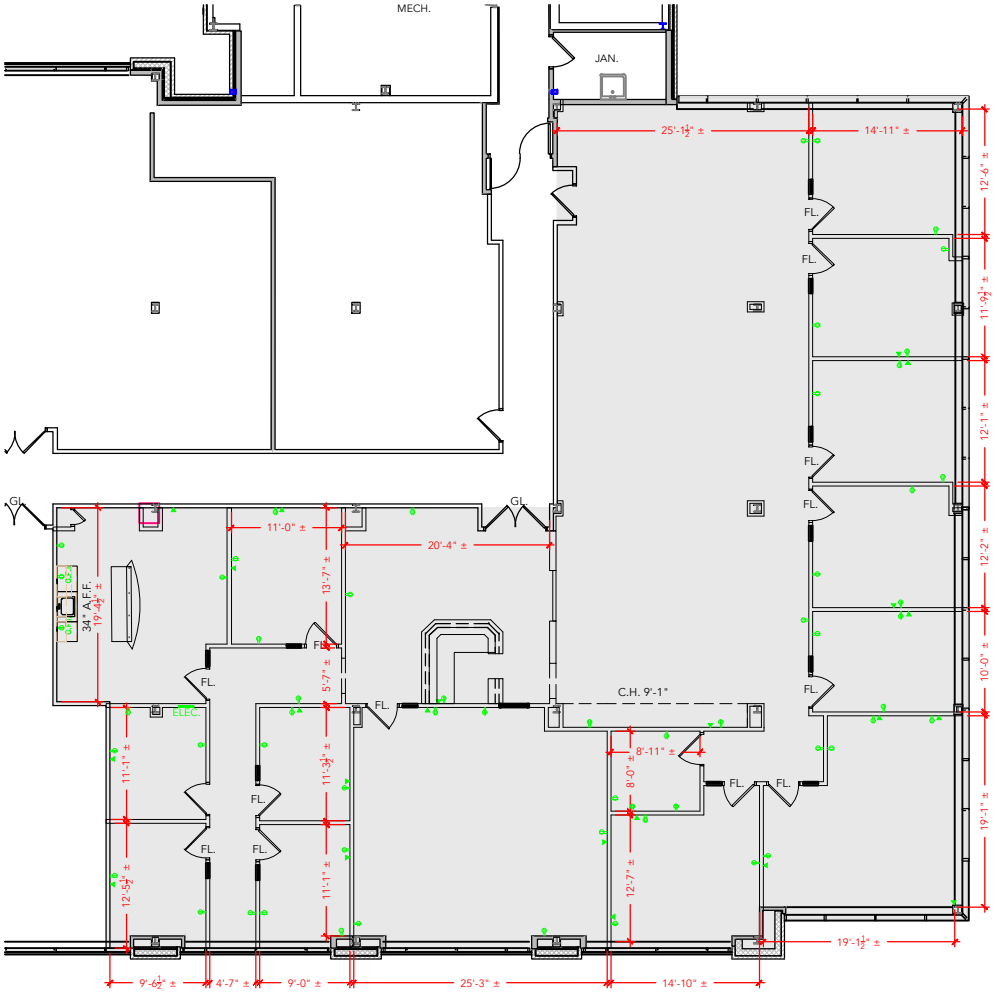

Floor Plan

PLAN NOT TO SCALE - THIS IS NOT A CONSTRUCTION DOCUMENT

DRAWING #: SC10-200-210 ASBUILT DATE: 09.23.25