230 SCHILLING CIRCLE

230 SCHILLING CIRCLE, HUNT VALLEY, MD 21031
SUITE 236-274

TOTAL SF AVAILABLE - 20,629 RSF(12%)

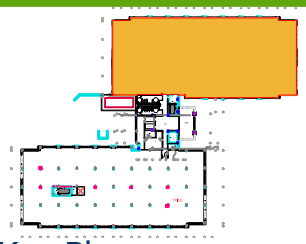

Key Plan

Click to access **3D** model

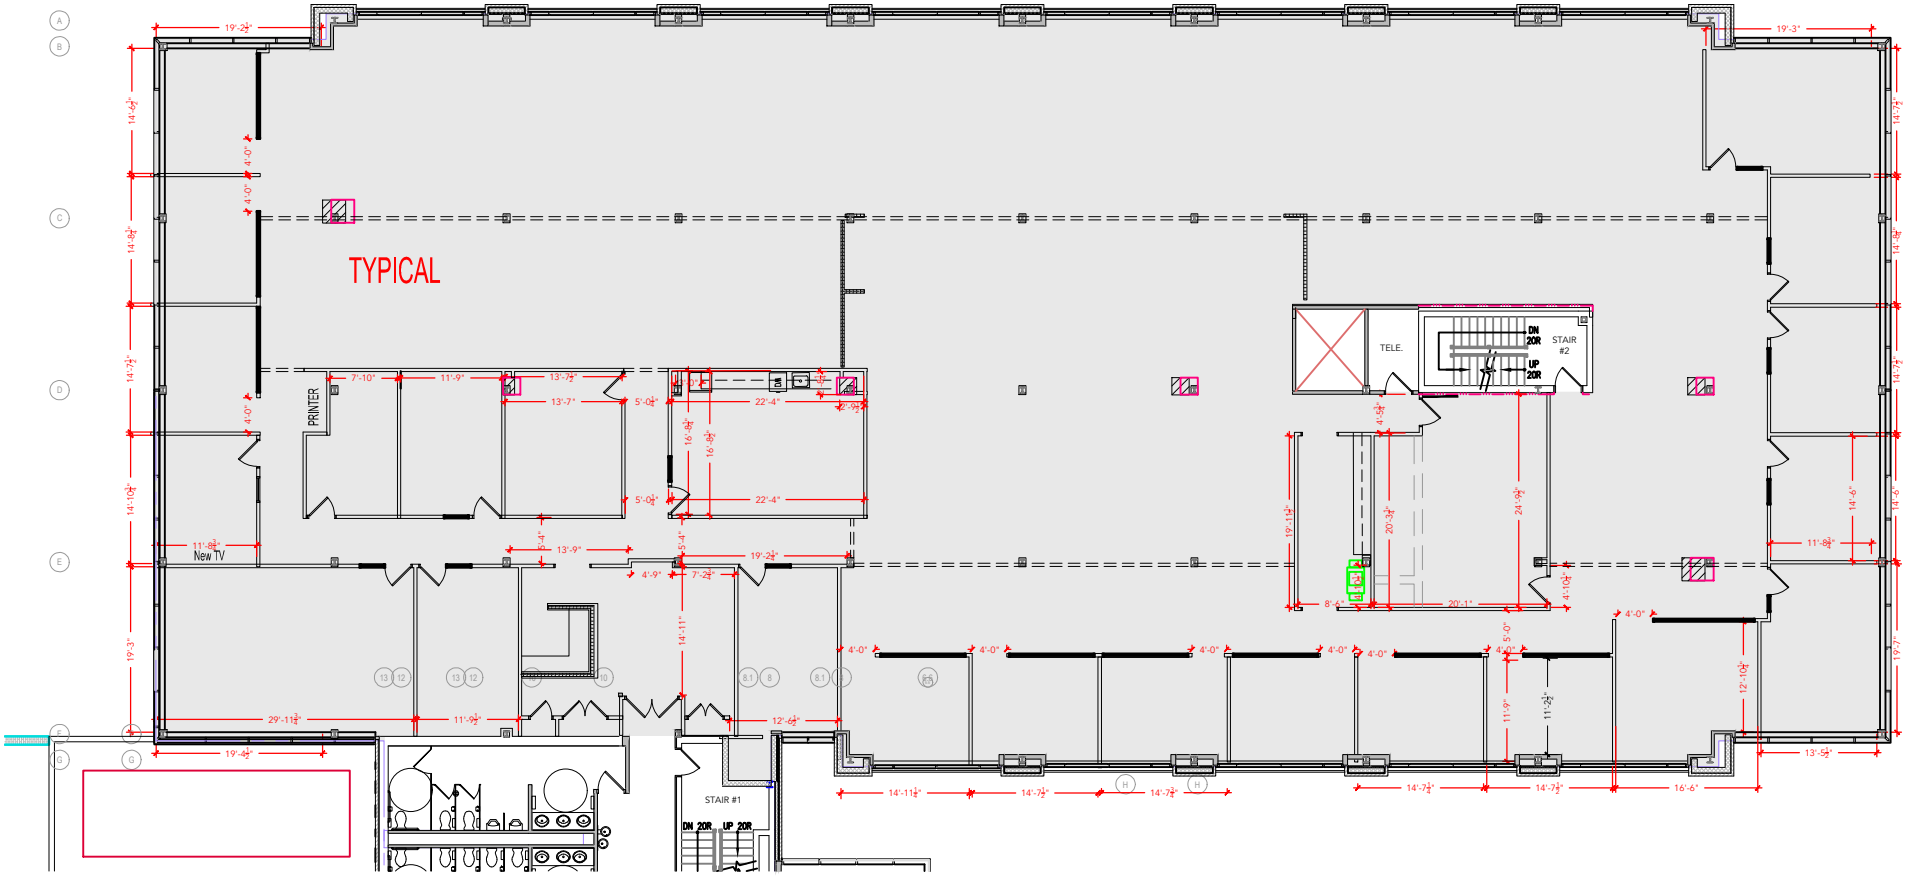

Floor Plan

PLAN NOT TO SCALE - THIS IS NOT A CONSTRUCTION DOCUMENT

DRAWING #: SC10-236-274 ASBUILT DATE: **NEEDS TO BE**