SCHILLING SQUARE

215 SCHILLING CIRCLE HUNT VALLEY, MD 21031
SUITE 110(R)

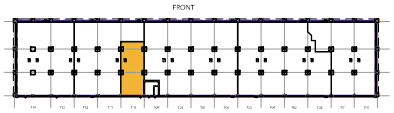

TOTAL SF AVAILABLE - 2,112 SF

OFFICE - 2,112 SF
WAREHOUSE - 0,000 SF

Click to access **3D** model

Key Plan

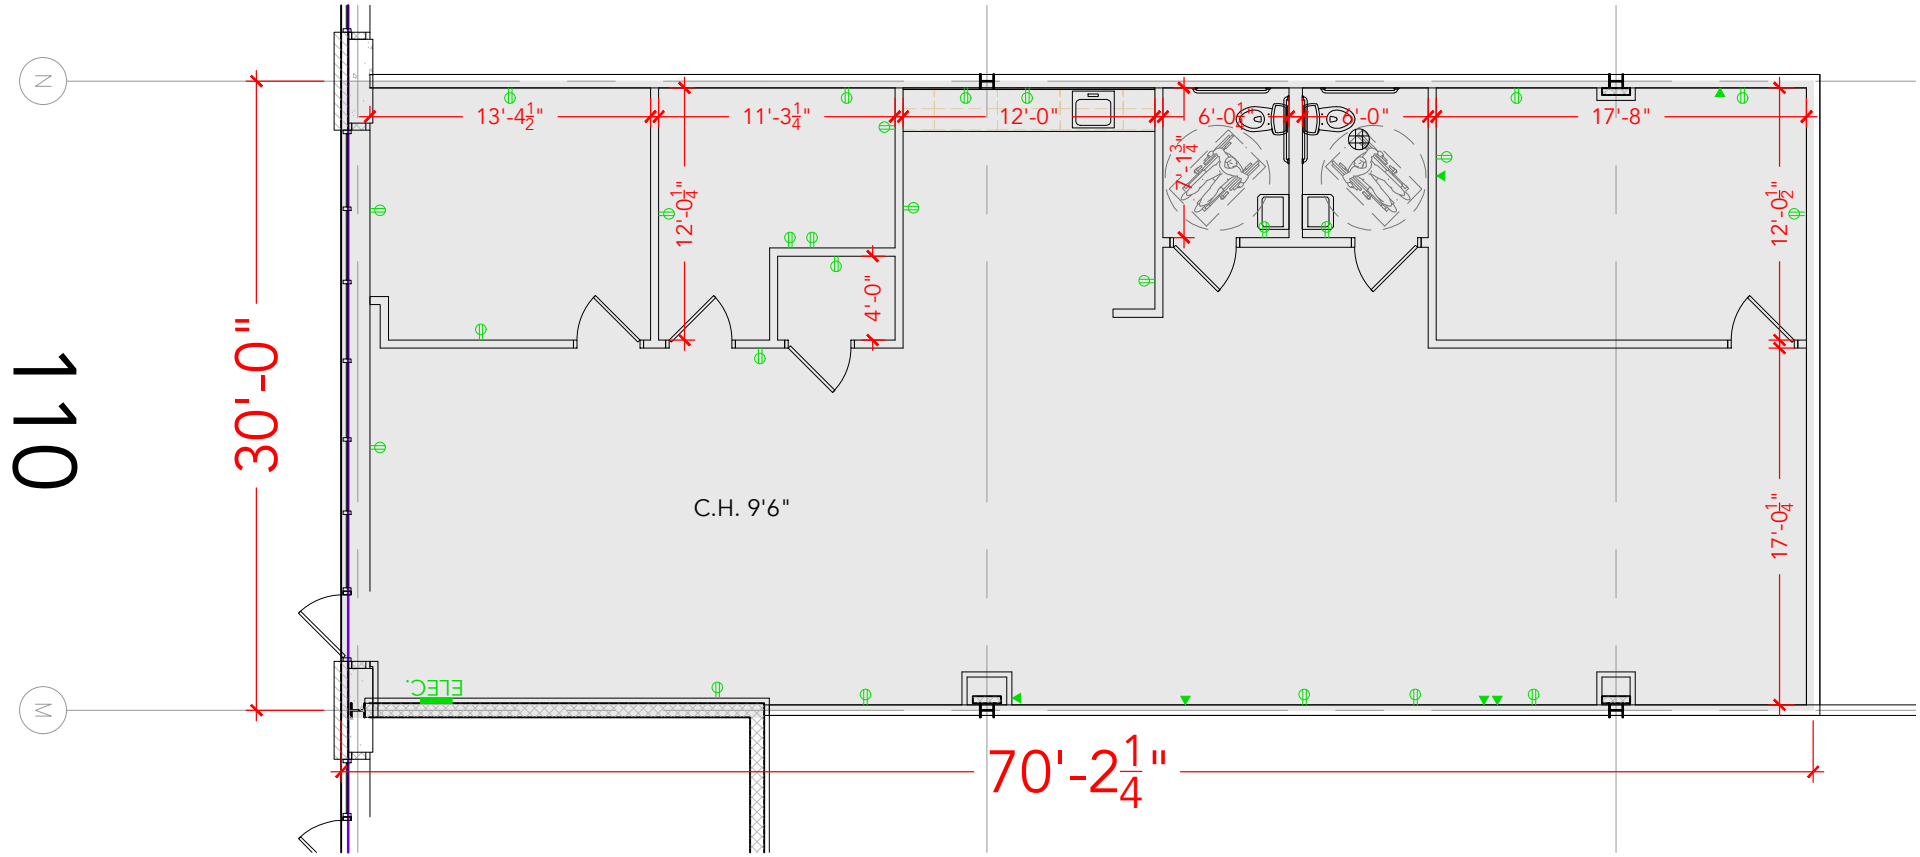

Floor Plan

PLAN NOT TO SCALE - THIS IS NOT A CONSTRUCTION DOCUMENT

DRAWING #: SC2-110(R)ASBUILT DATE:**11.15.19**