TIMONIUM ONE

1966 GREENSPRING DRIVE, TIMONIUM, MD 21093
SUITE 300

TOTAL SF AVAILABLE -28,962 RSF (9%)

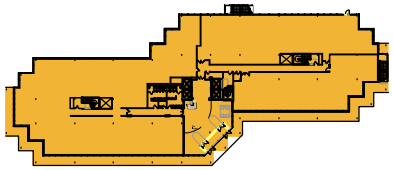

Key Plan

Click to access **CADD file**

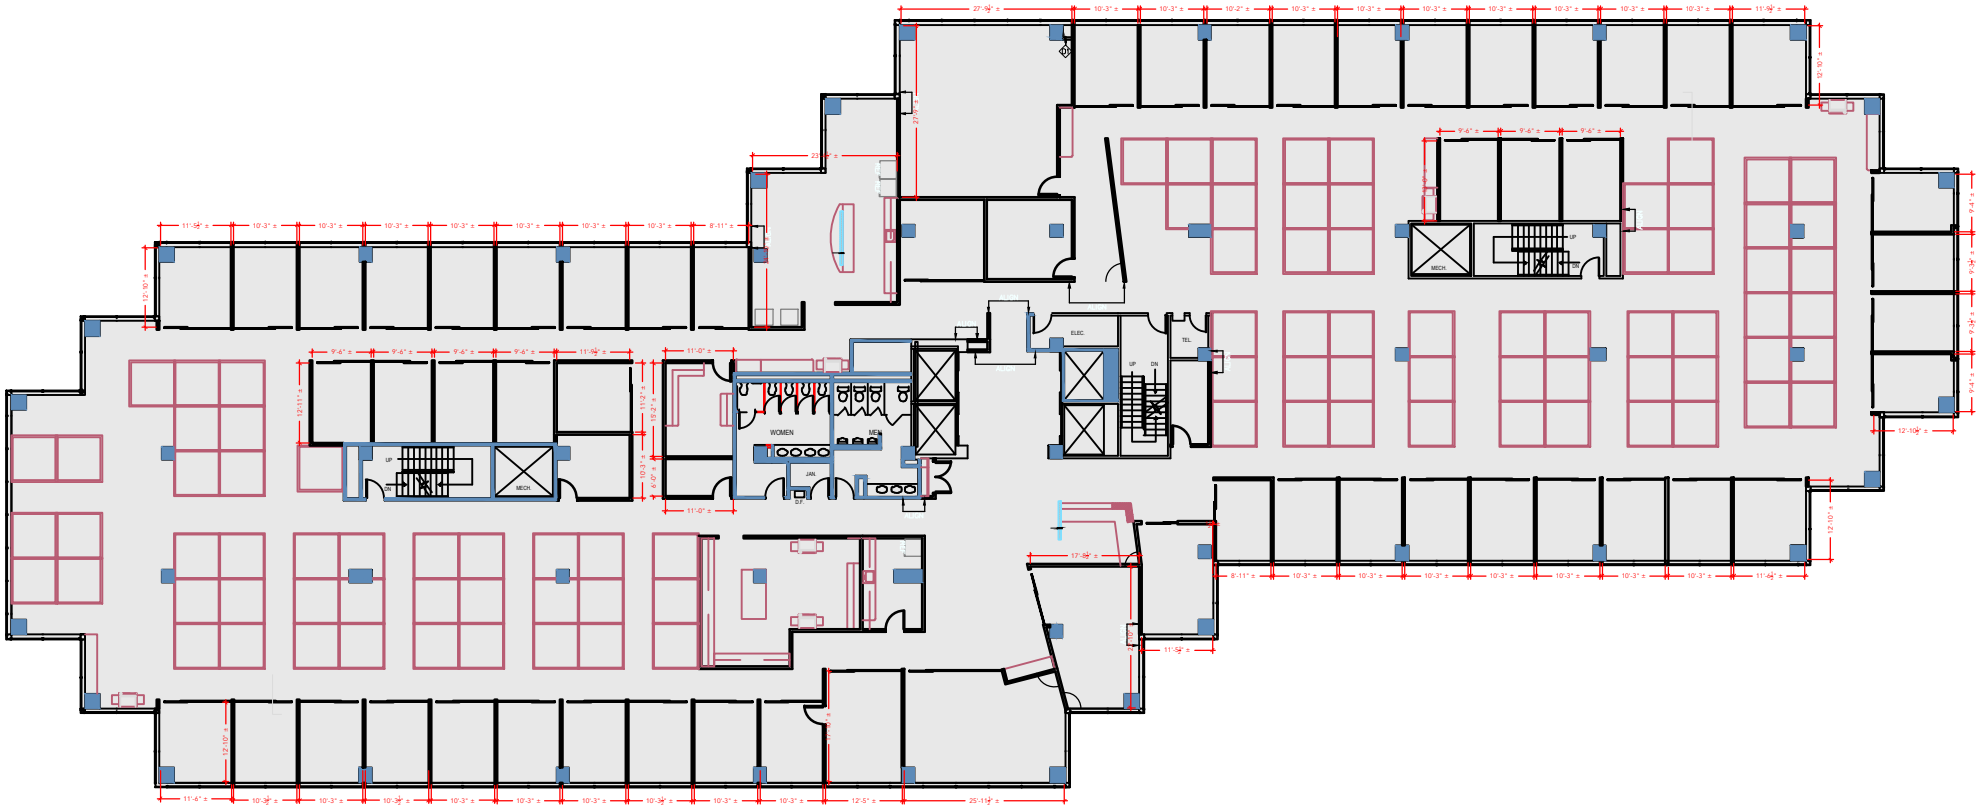

Floor Plan

PLAN NOT TO SCALE - THIS IS NOT A CONSTRUCTION DOCUMENT

DRAWING #: TD3-300 ASBUILT DATE: **NEEDS TO BE**