TIMONIUM TWO

1954 GREENSPRING DRIVE TIMONIUM, MD 21093

SUITE 580-590

TOTAL SF AVAILABLE - 5,476 RSF(12%)

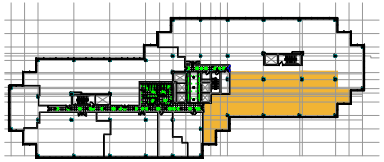

Key Plan

Click to access **CADD file**

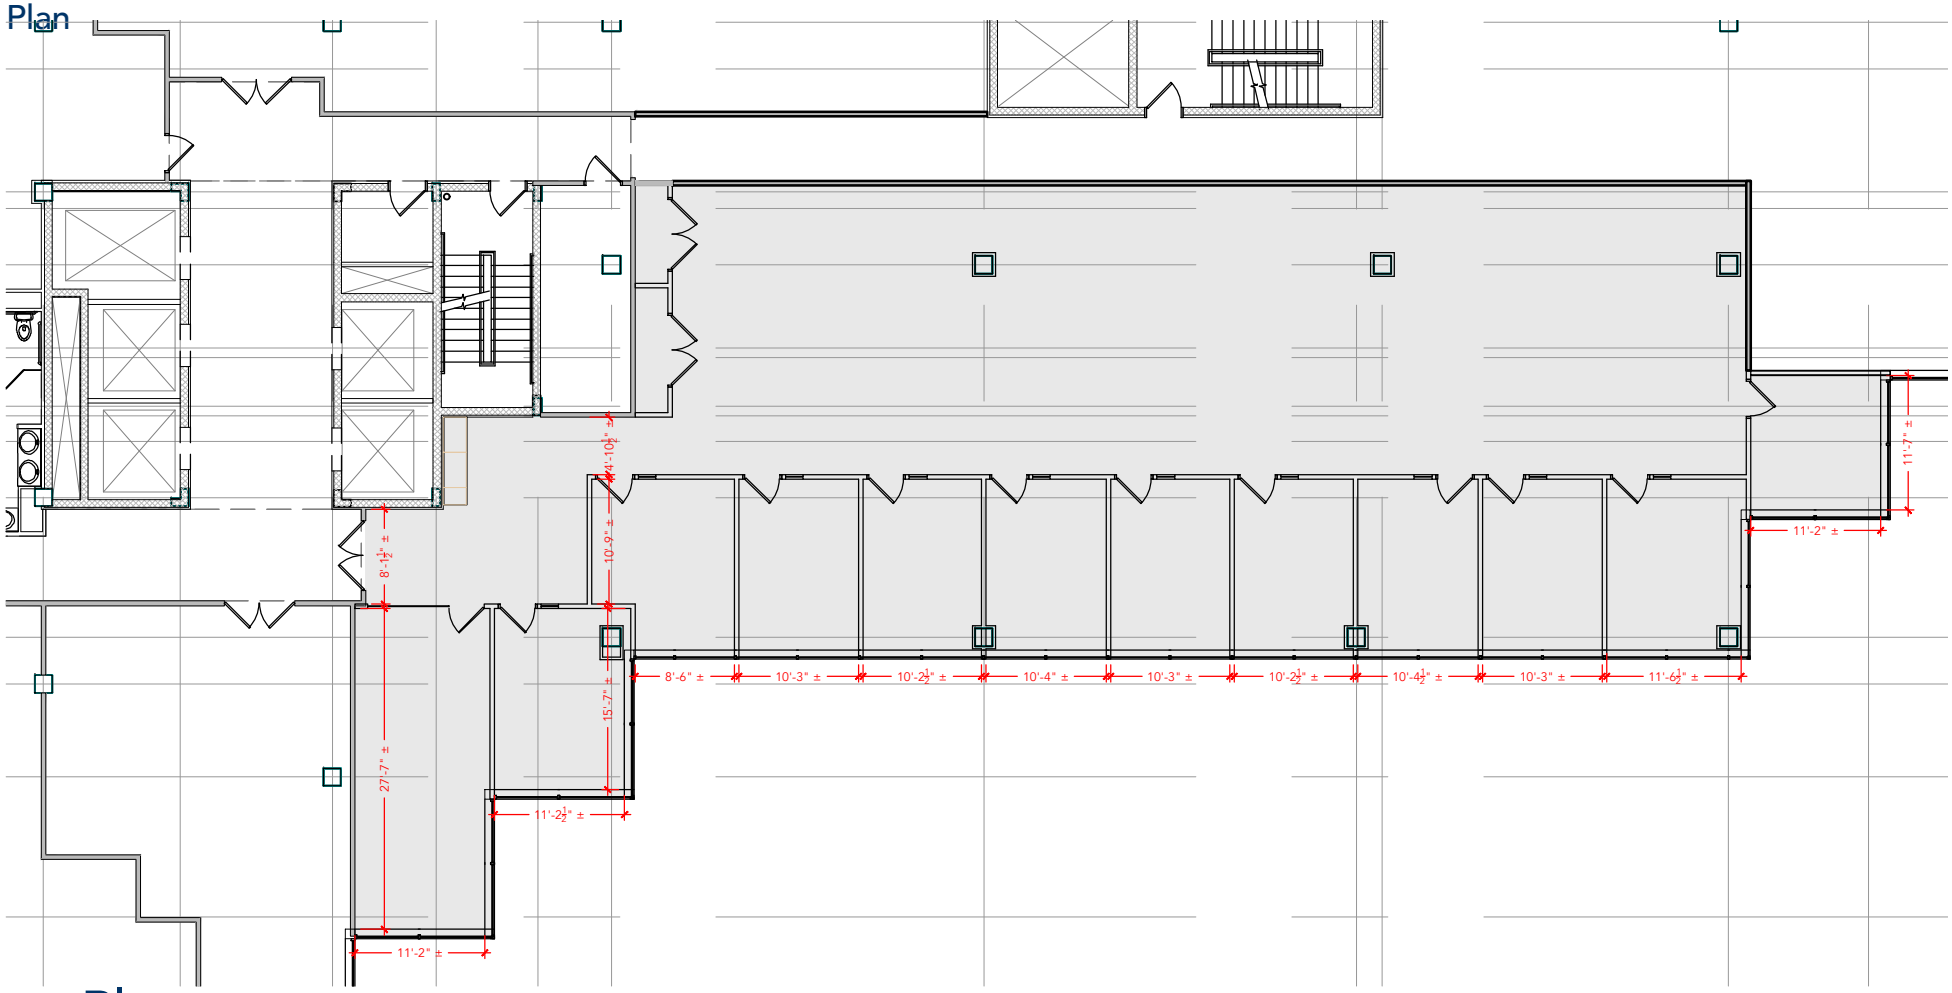

Floor Plan

PLAN NOT TO SCALE - THIS IS NOT A CONSTRUCTION DOCUMENT

DRAWING #: TD4-580-595 ASBUILT DATE: **NEEDS TO BE**