TROY HILL TECH CENTER

7195 TROY HILL DRIVE ELKRIDGE, MD 21075

SUITE 107-108

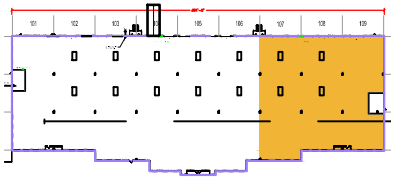

Key Plan

TOTAL SF AVAILABLE - 13,574 SF

OFFICE - 4,730 SF

WAREHOUSE - 8,844 SF

Click to access **3D** model

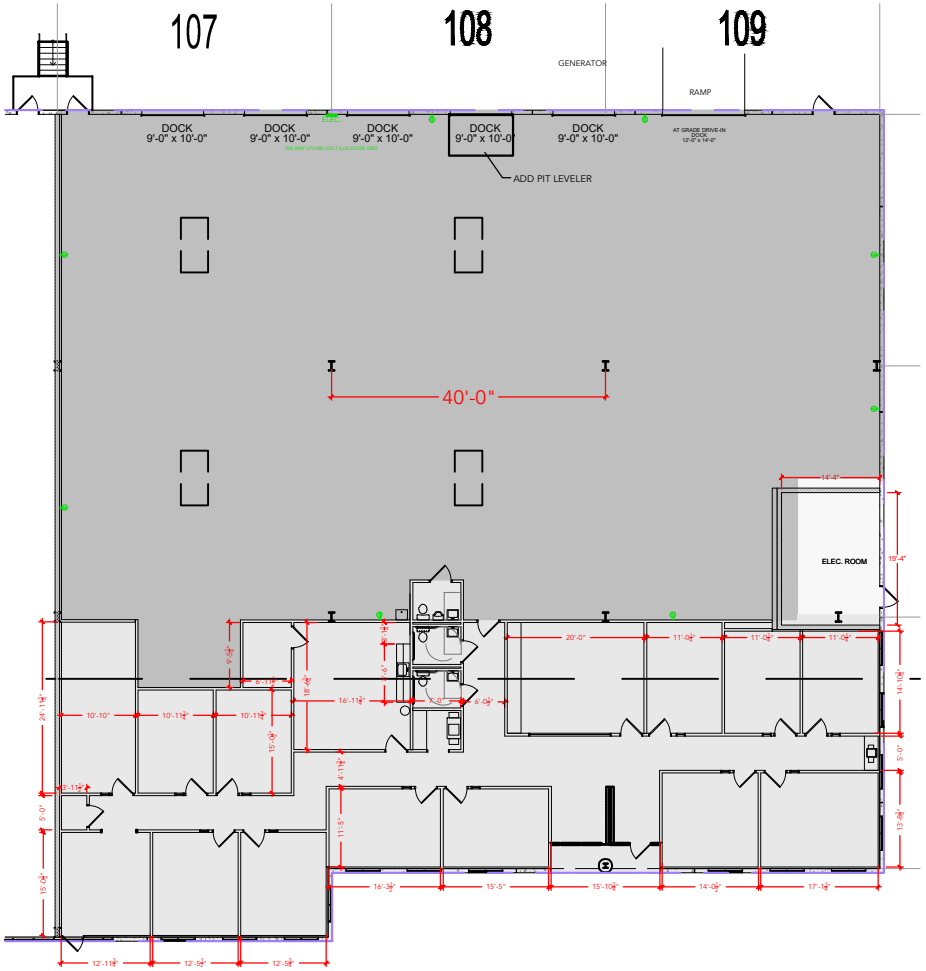

Floor Plan

PLAN NOT TO SCALE - THIS IS NOT A CONSTRUCTION DOCUMENT

DRAWING #: TH1-107-109 ASBUILT DATE: **08.16.15**