HUNT VALLEY BUSINESS CENTER

10923-10925 MCCORMICK ROAD, HUNT VALLEY, MD 21031

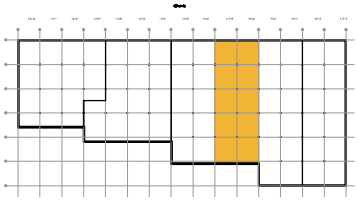

Key Plan

TOTAL SF AVAILABLE - 10,200 SF

OFFICE - 2,213 SF

WAREHOUSE SF - 7,987 SF

Click to access **3D** model

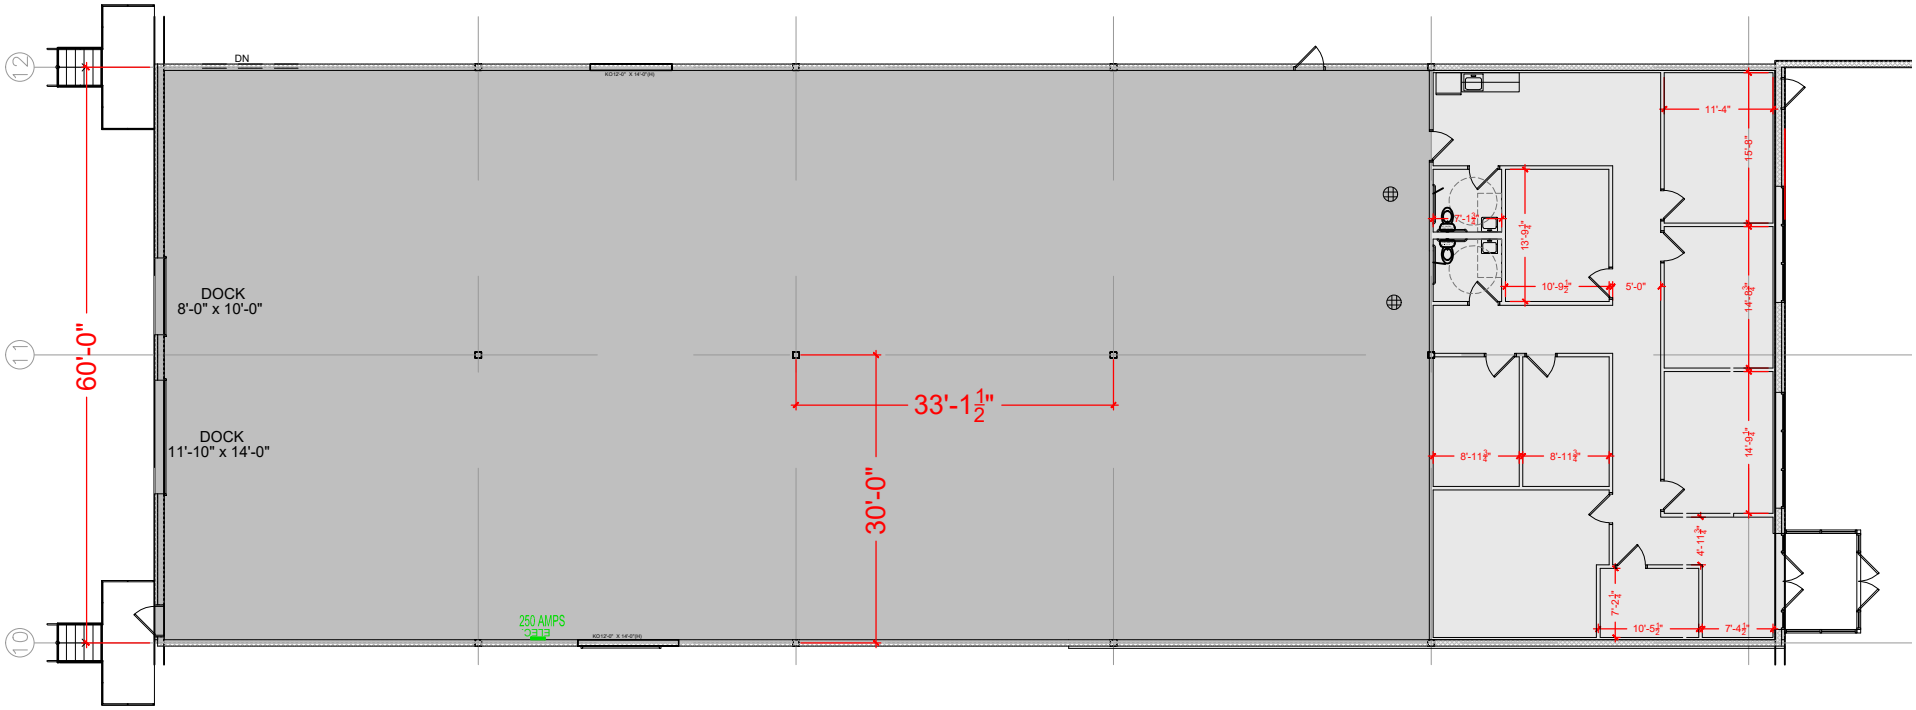

Floor Plan

PLAN NOT TO SCALE - THIS IS NOT A CONSTRUCTION DOCUMENT

DRAWING #: VA1-10923-10925 ASBUILT DATE:07.20.2017