MERRITT CAPITAL

741 MERRITT CAPITAL DRIVE, WAKE FOREST, NC 27587

SUITE 113

TOTAL SF AVAILABLE - 3,621 RSF

OFFICE - 1,697 RSF

WAREHOUSE - 1,924 RSF

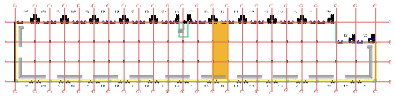

Key Plan

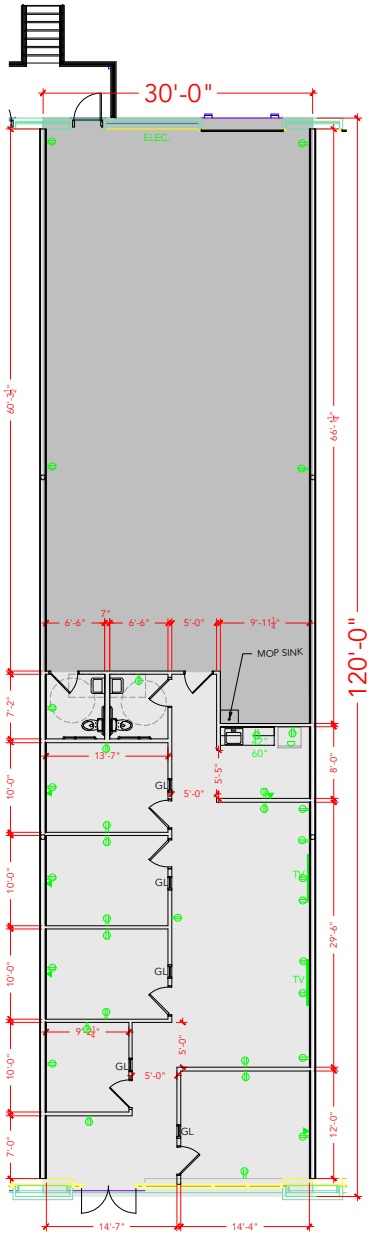

Floor Plan

PLAN NOT TO SCALE - THIS IS NOT A CONSTRUCTION DOCUMENT

DRAWING #: WF3-D1-113 ASBUILT DATE: NEEDS TO BE