merritt PROPERTIES

100 WEST ROAD

100 WEST ROAD TOWSON, MD 21204
SUITE 112

TOTAL SF AVAILABLE - 801 RSF(12%)

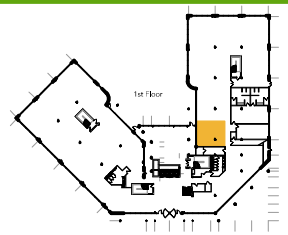

Key Plan

Click to access **3D** model

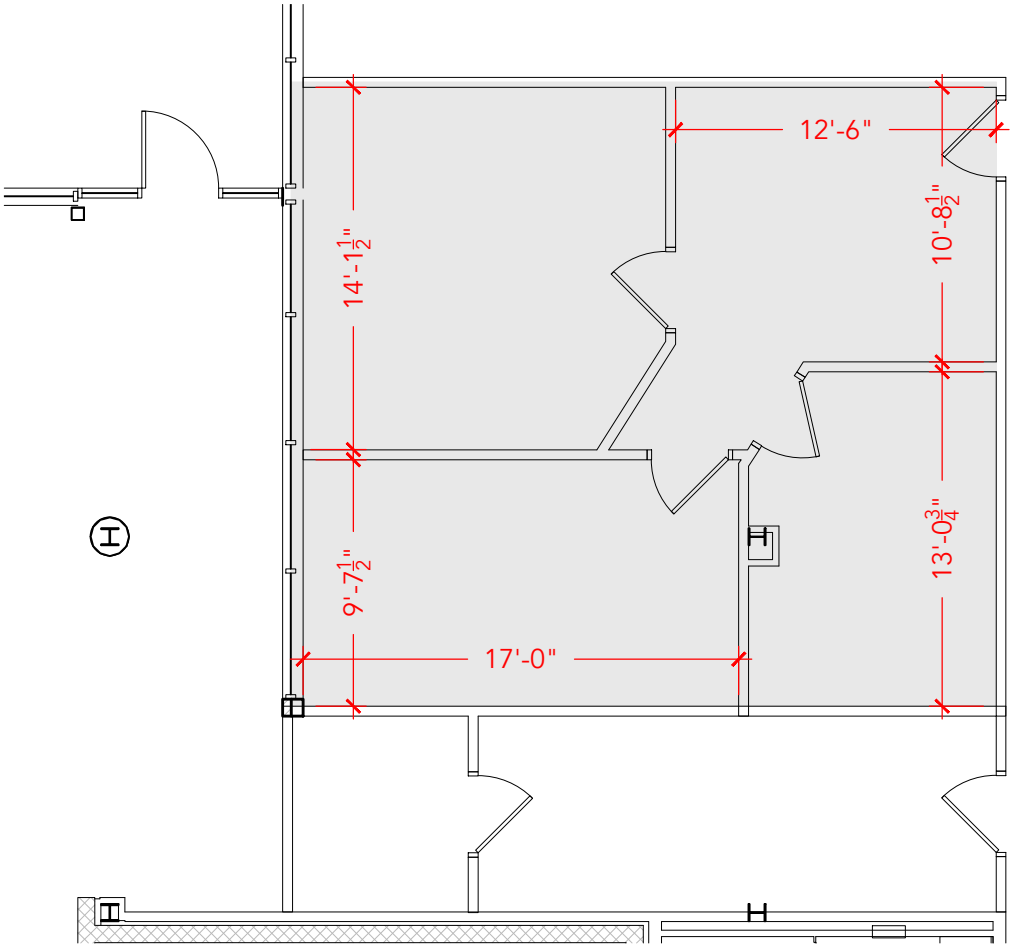

Floor Plan

PLAN NOT TO SCALE - THIS IS NOT A CONSTRUCTION DOCUMENT

DRAWING #: WR1-112 ASBUILT DATE: **01.24.18**