100 WEST ROAD

100 WEST ROAD TOWSON, MD 21204

SUITE 402

TOTAL SF AVAILABLE - 736 RSF (12%)

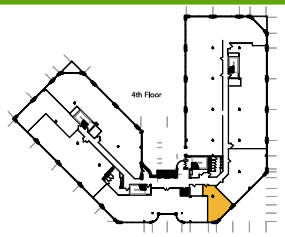

Key Plan

Click to access **3D** model

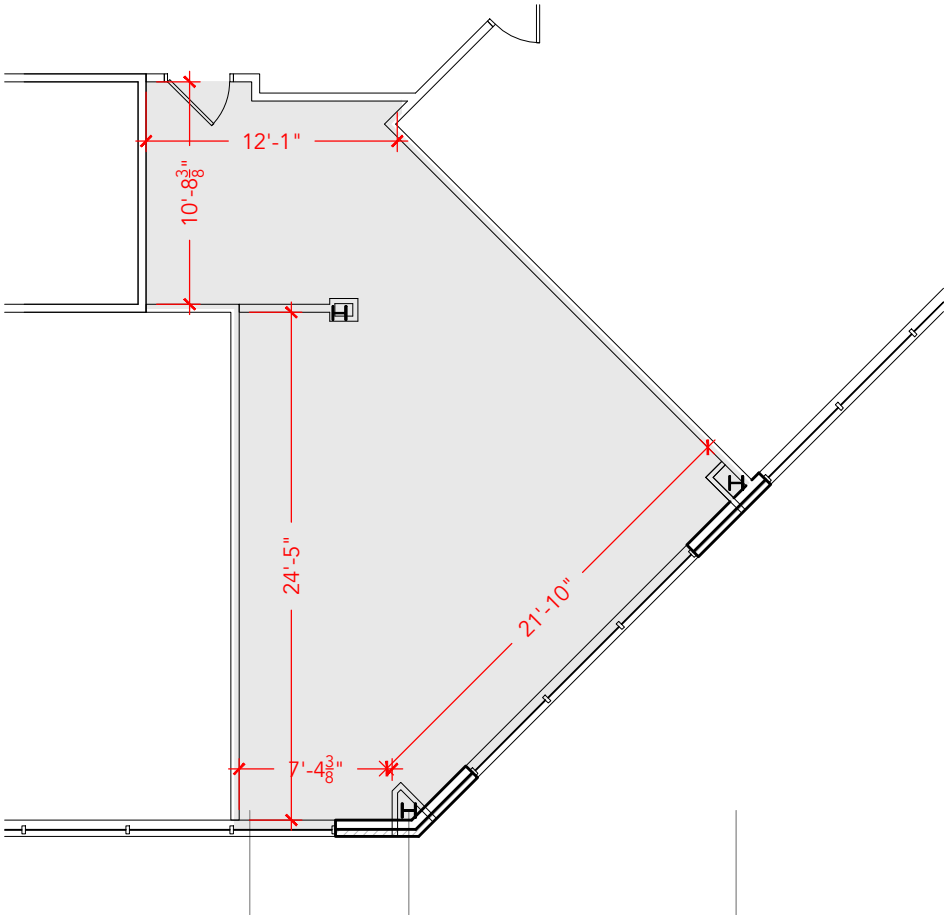

Floor Plan

PLAN NOT TO SCALE - THIS IS NOT A CONSTRUCTION DOCUMENT

DRAWING #: WR1-402 ASBUILT DATE: **01.10.2018**