100 WEST ROAD

100 WEST ROAD TOWSON, MD 21204

SUITE 504

TOTAL SF AVAILABLE -2,434 RSF (12%)

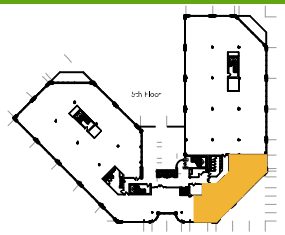

Key Plan

Click to access **CADD file**

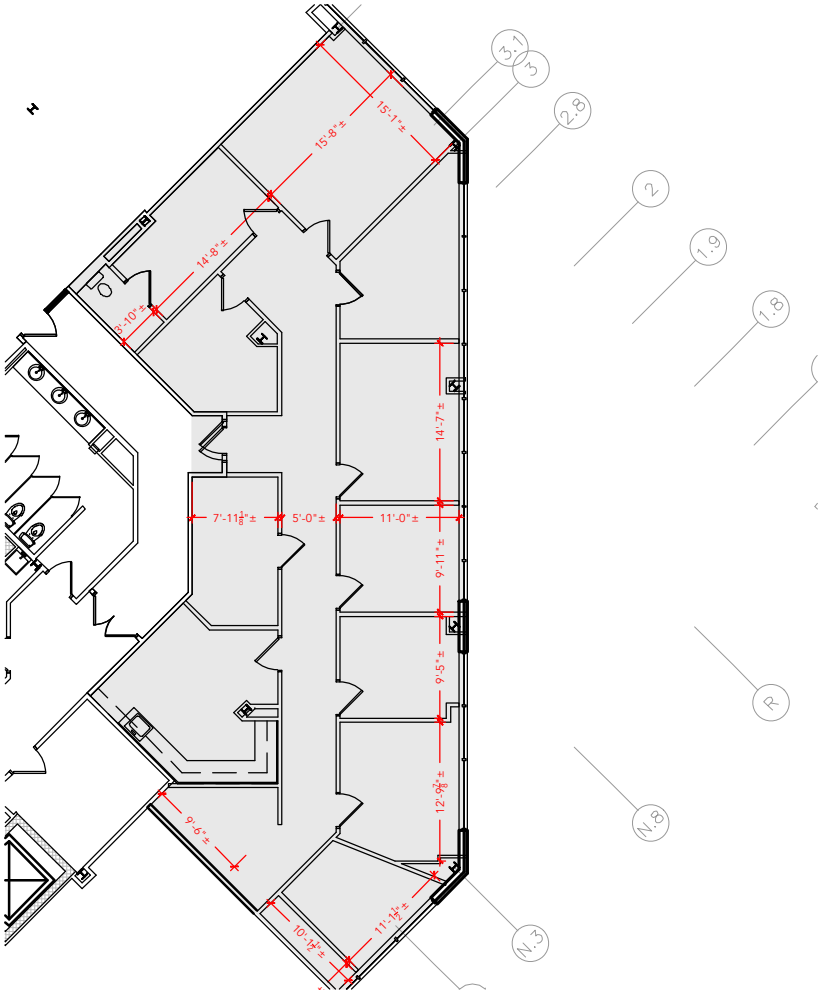

Floor Plan

PLAN NOT TO SCALE - THIS IS NOT A CONSTRUCTION DOCUMENT

DRAWING #: WR1-504 ASBUILT DATE: **NEEDS TO BE**