COLUMBIA CORPORATE PARK

8850 STANFORD BLVD. COLUMBIA, MD 21045

SUITE 1750-1900

TOTAL SF AVAILABLE - 5,444 RSF(12%)

Click to access **3D** model

Key Plan

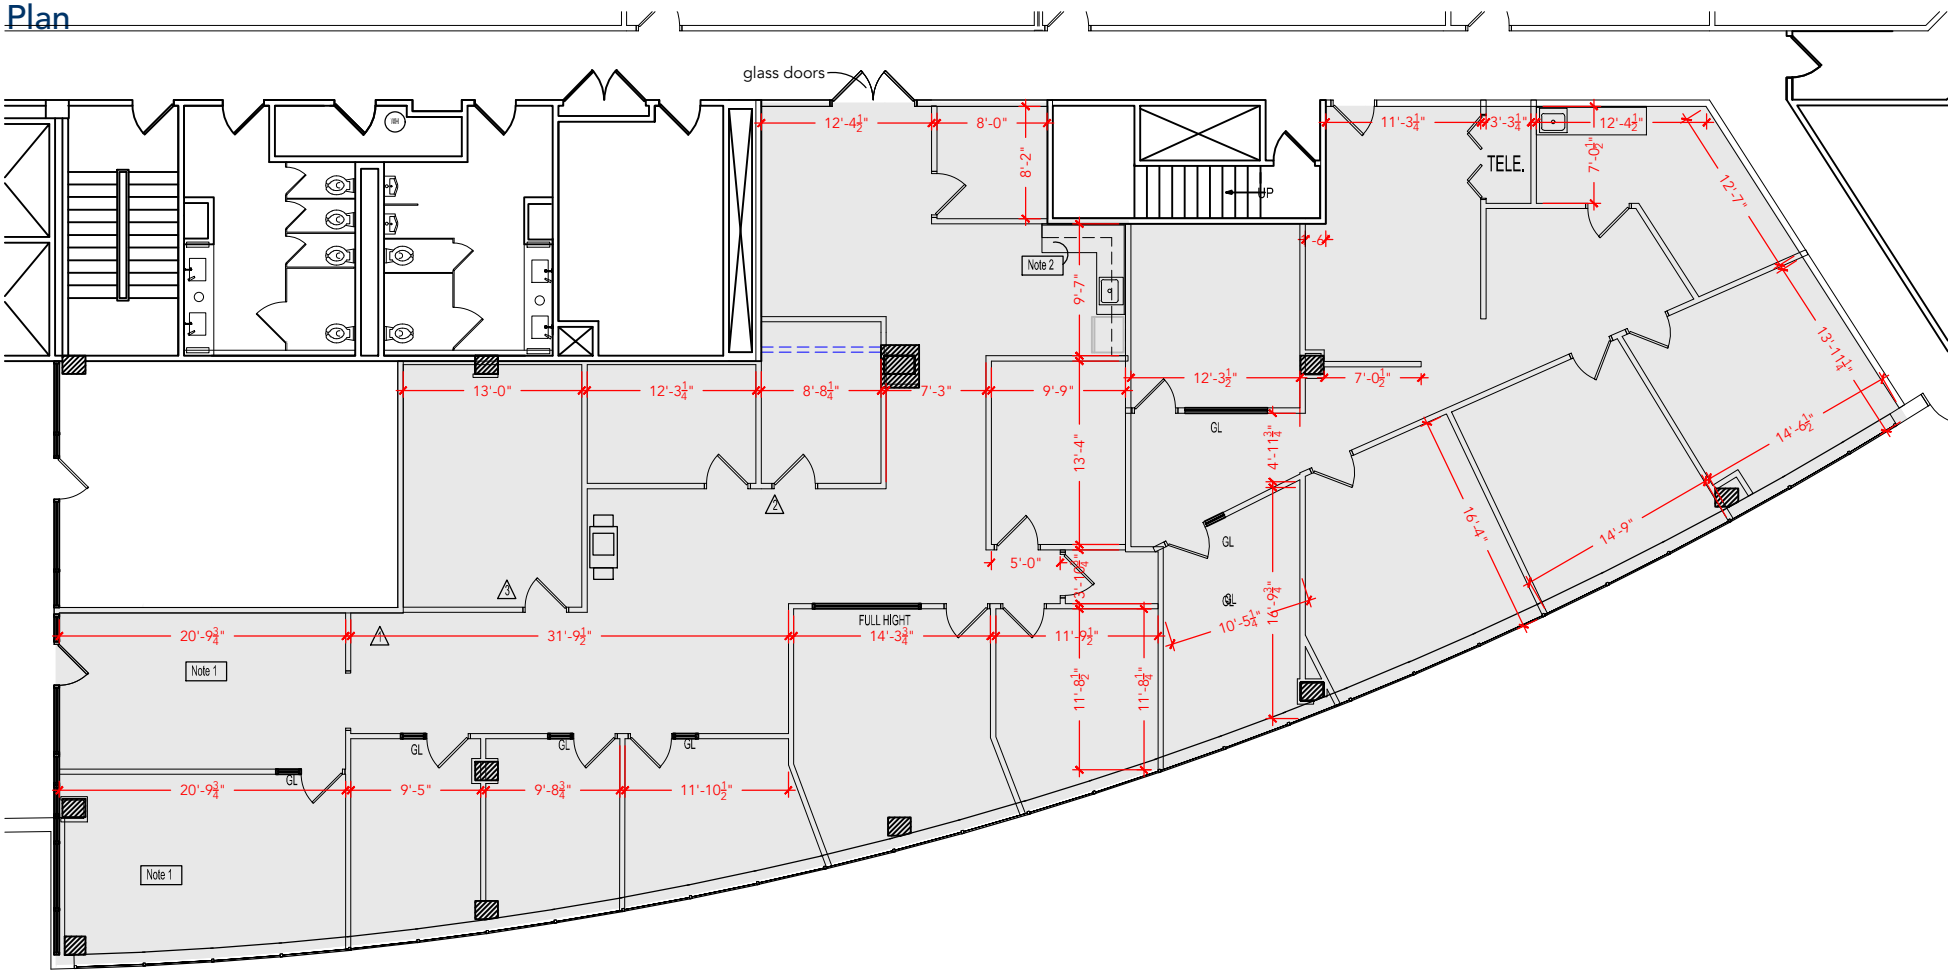

Floor Plan

PLAN NOT TO SCALE - THIS IS NOT A CONSTRUCTION DOCUMENT

DRAWING #: ZA1-1750-1900 ASBUILT DATE: NEEDS TO BE