COLUMBIA CORPORATE PARK

8850 STANFORD BLVD. COLUMBIA, MD 21045

SUITE 3300-3500

TOTAL SF AVAILABLE -11,245 RSF(12%)

Click to access **3D** model

Key Plan

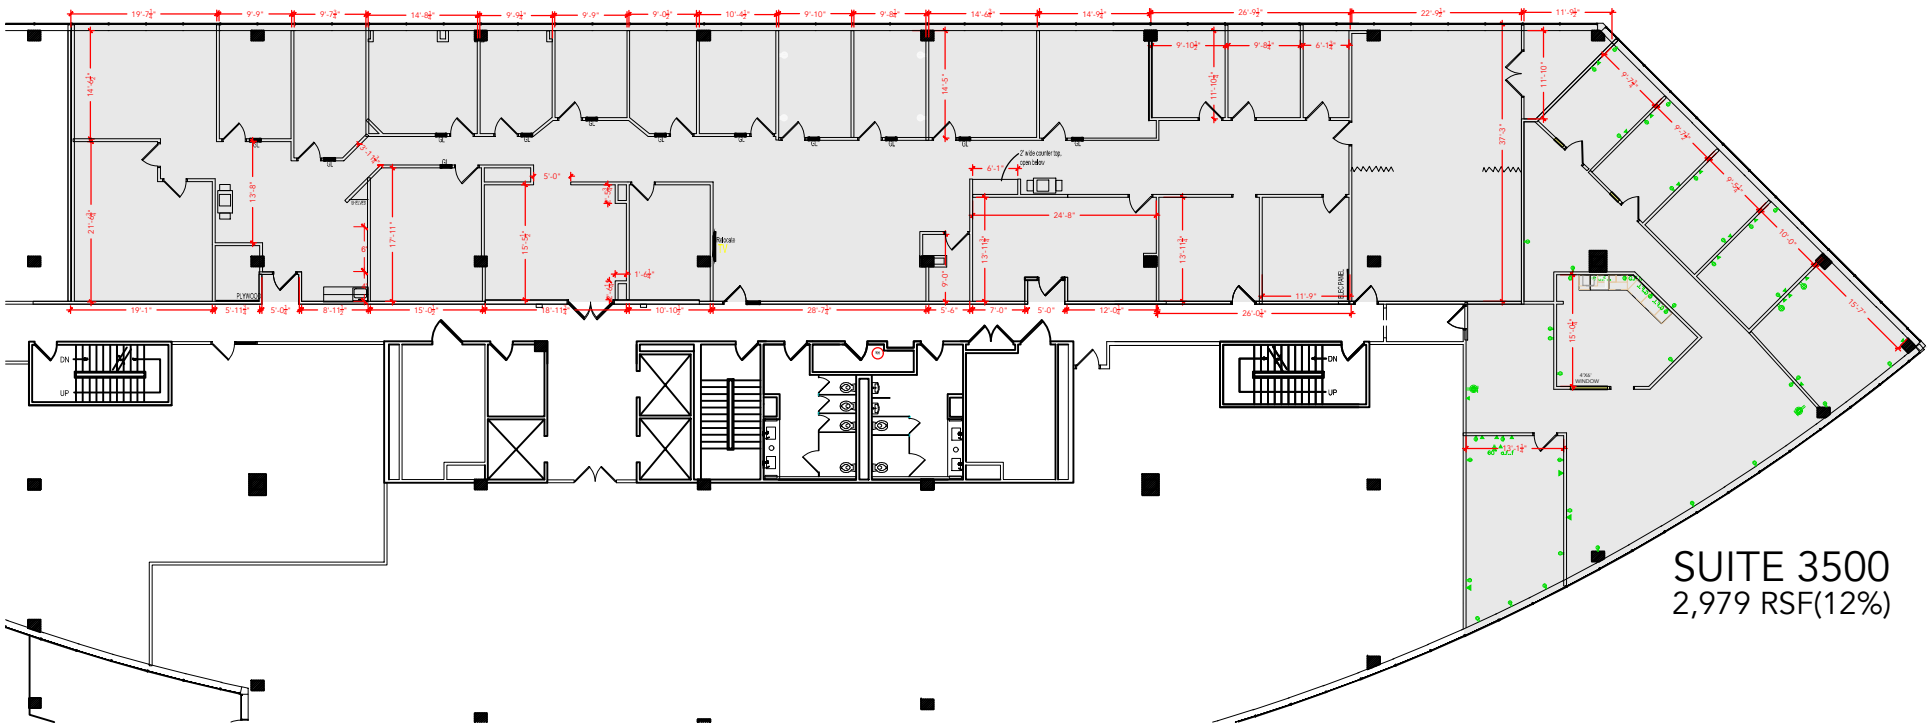

Floor Plan

PLAN NOT TO SCALE - THIS IS NOT A CONSTRUCTION DOCUMENT

DRAWING #: ZA1-3300-3500 ASBUILT DATE:**NEEDS TO BE**