merritt PROPERTIES

COLUMBIA CORPORATE PARK

8850 STANFORD BLVD. COLUMBIA, MD 21045
SUITE 4000

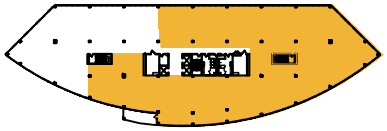

TOTAL SF AVAILABLE - 19,043 RSF (16%)

Click to access **3D** model

Key Plan

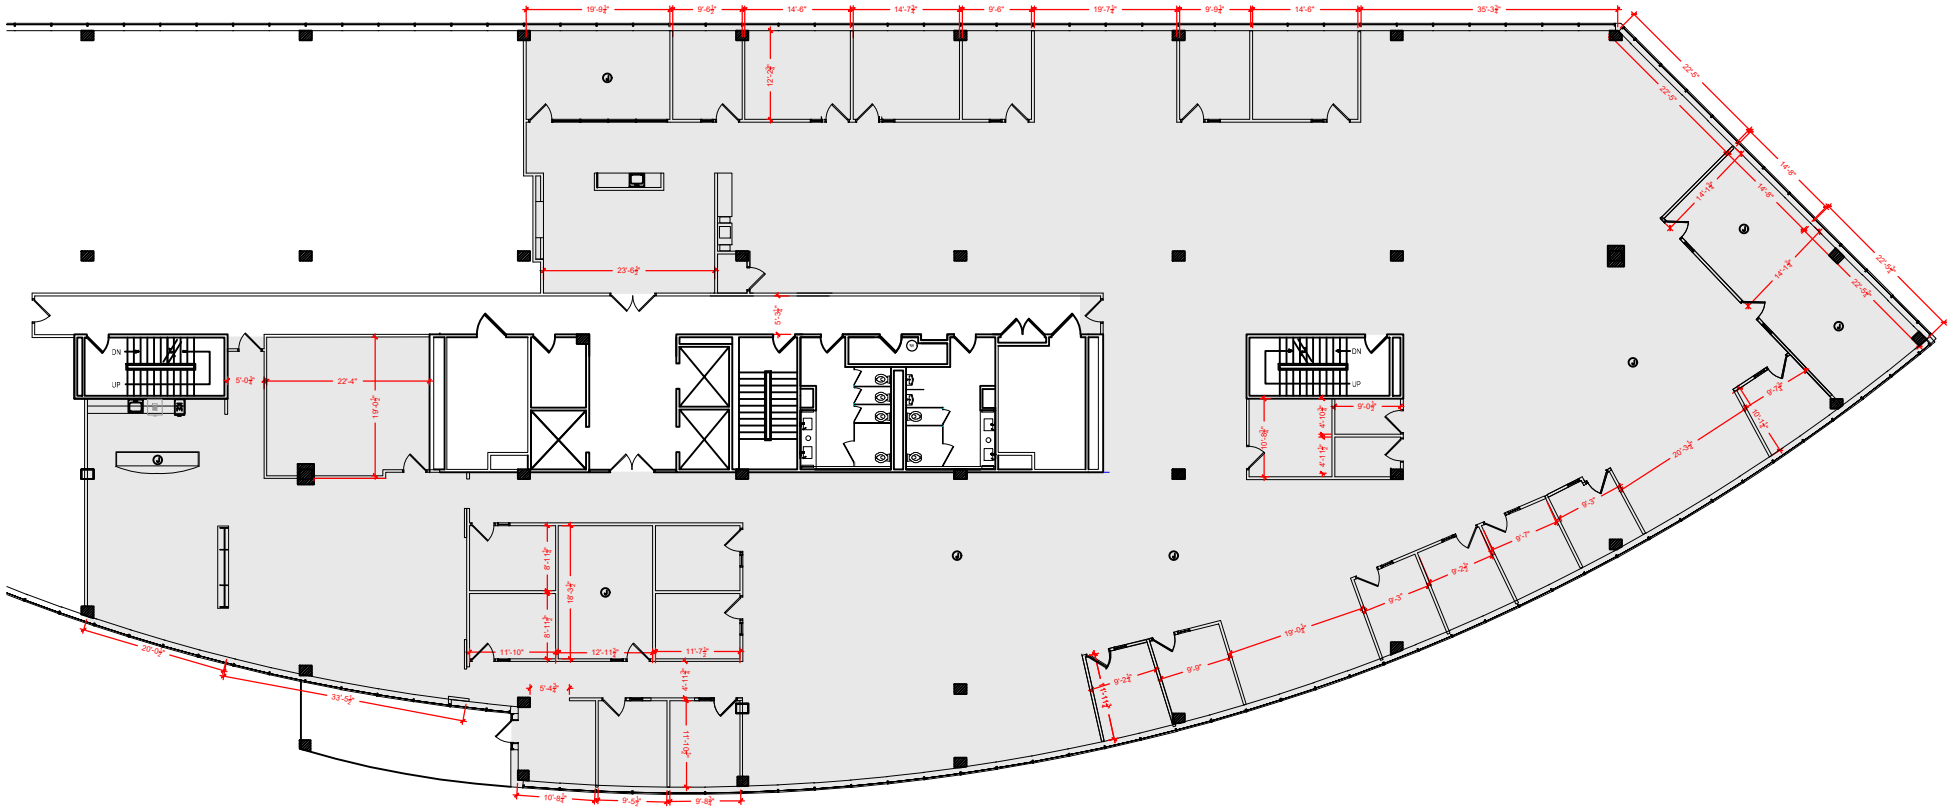

Floor Plan

PLAN NOT TO SCALE - THIS IS NOT A CONSTRUCTION DOCUMENT

DRAWING #: ZA1-4000 ASBUILT DATE: NEEDS TO BE