merritt PROPERTIES

COLUMBIA CORPORATE PARK

8840 STANFORD BLVD COLUMBIA, MD 21045

SUITE 4300-4400

TOTAL SF AVAILABLE - 11,109 RSF(16%)

Key Plan

Click to access **CADD file**

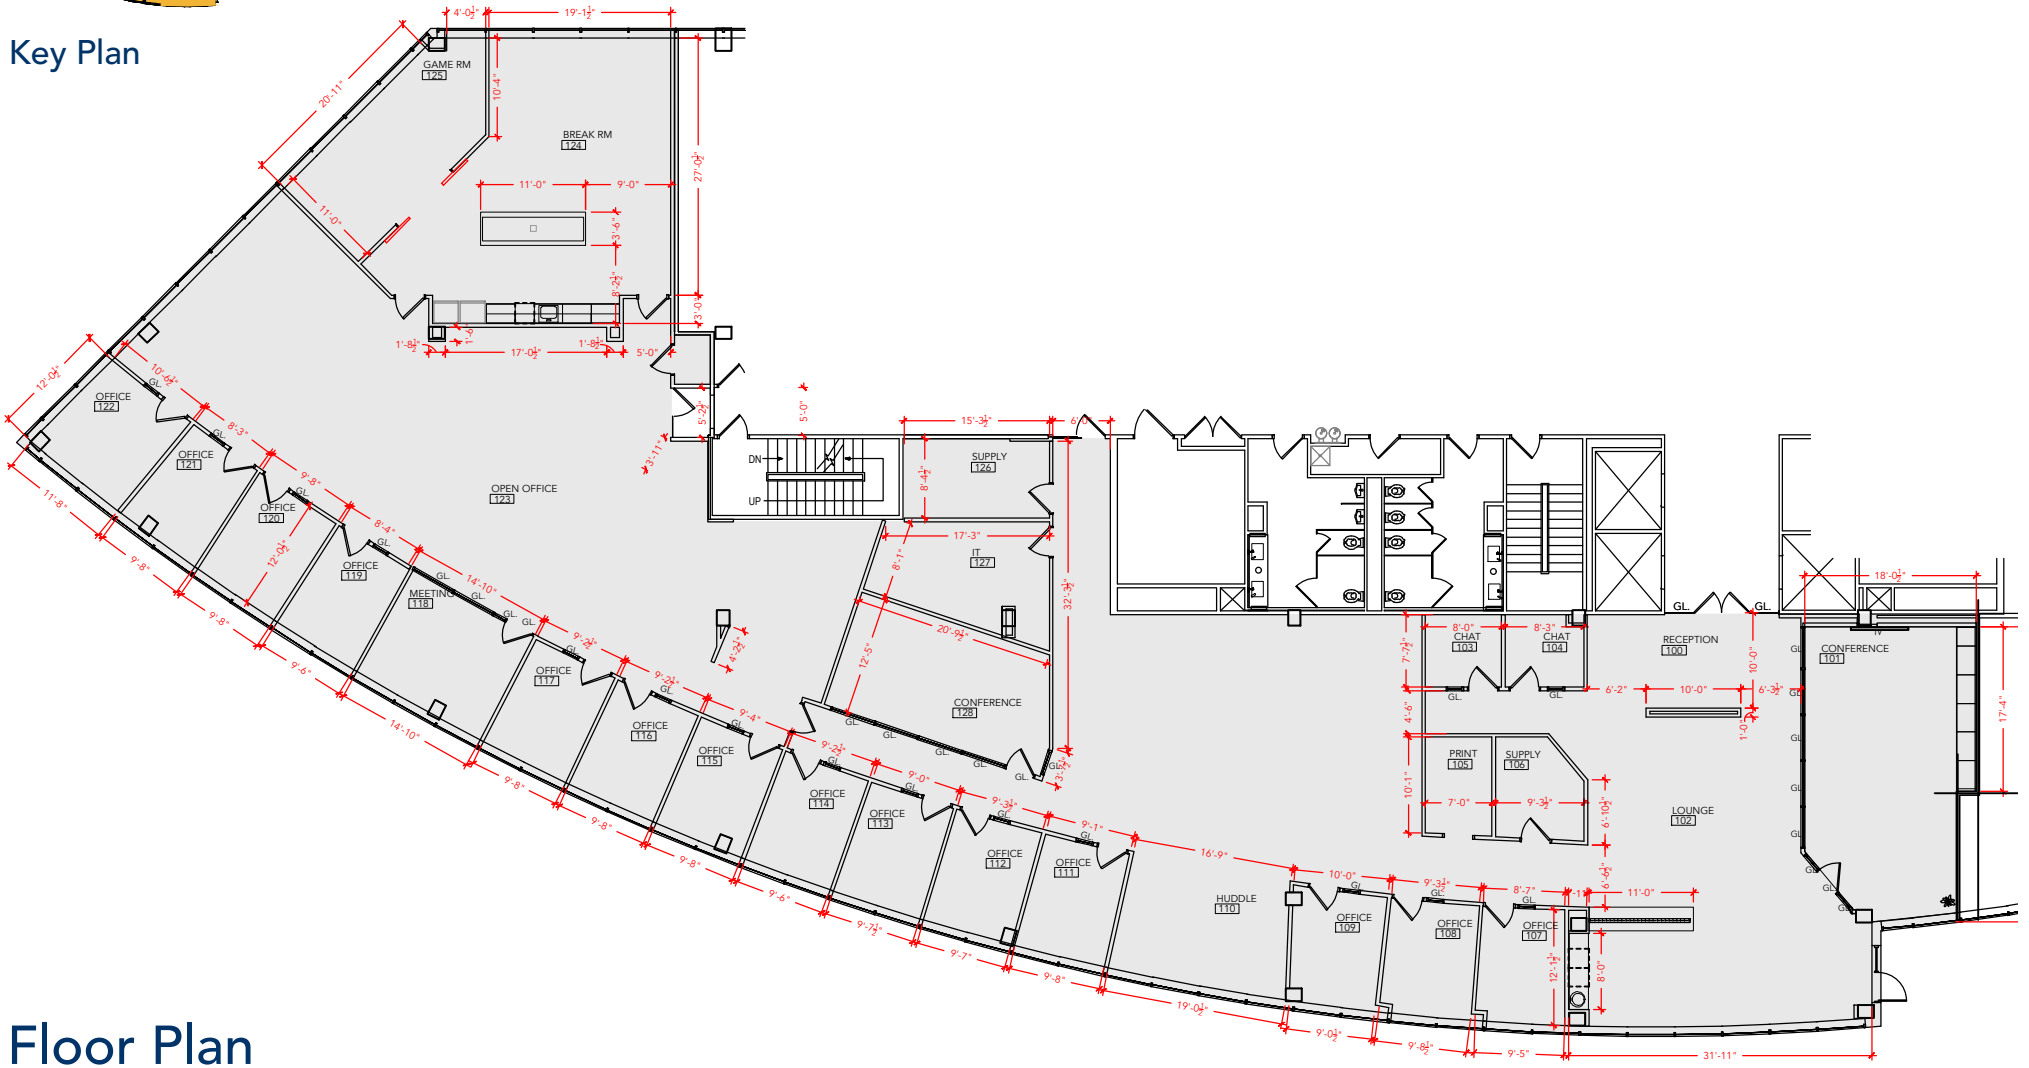

Floor Plan

PLAN NOT TO SCALE - THIS IS NOT A CONSTRUCTION DOCUMENT

DRAWING #: BH1-4300-4400 ASBUILT DATE: 11.08.18