COLUMBIA CORPORATE PARK

8840 STANFORD BLVD COLUMBIA, MD 21045

SUITE 4300

TOTAL SF AVAILABLE - 4,940 RSF(16%)

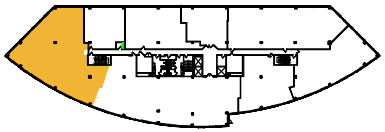

Key Plan

Click to access **CADD file**

Floor Plan

PLAN NOT TO SCALE - THIS IS NOT A CONSTRUCTION DOCUMENT

DRAWING #: BH1-4300 ASBUILT DATE: 11.08.18